

**SURVEY &  
REMONUMENTATION**

**FEB 17 1998**

**BARRY COUNTY REMONUMENTATION**

**LAND CORNER RECORDATION CERTIFICATE**  
Filing Requirement of Act 74, Mich. P.A. 1970

**SECTION**

For Corners in  
BARRY  
(county)

Located In:

Corner Code #



**2662**  
Page: 1 of 1  
12/19/1997 07:49A

Sandy Schondelmayer - Barry Co. LCRCR

1. Public Land Survey T 4N R 7W M-2  
EAST 1/4 CORNER  
SECTION 1  
WOODLAND TOWNSHIP  
ON RANGE LINE
2. Property Controlling in Section S      T      R       
S      T      R
3. Miscellaneous Property in Sec. S      T      R       
S      T      R
4. Lot No         , Recorded Plat
5. Private Claims

Register of Deeds Stamp & File Number

I, **Brian Reynolds**, in a field survey on **10 DECEMBER, 1996** do hereby certify that under requirements of P.A. 74, Michigan P.A. of 1970, the corner points mentioned in lines 1 and 2 above were in conformance with regulations and rules therefore as required in the current manual of survey instructions of the United States Department of the Interior, Bureau of Land Management or by a decree of a Court of Law and/or that the corner points mentioned in lines 3, 4, and 5 above were in conformance with the rules of the Michigan Board of Land Surveyors or by a Decree of a Court of Law, established, re-established, monumented, re-monumented, recovered, found as expressed below.

**NOTE: Not more than 2 corners, all in the same town and range, may be recorded on this certificate.**

	A	B	C	D	E	F	G	H	I	J	K	L	M
2	6	5	4	3	2	1							
3													
4	7	8	9	10	11	12							
6													
6	18	17	16	15	14	13							
7													
8	19	20	21	22	23	24							
9													
10	30	29	28	27	26	25							
11													
12	31	32	33	34	35	36							
13													

A. Description of original monument and accessories and/or subsequent restoration:

- GENERAL LAND OFFICE: L. LYON, D.S., 1826 (R7W, P.126) BEECH 10 S27W 51 Do. 5 N33W 13
- GRAND RAPIDS, LANSING, DETROIT RAILROAD CO.: 28 JUNE, 1887 (L.1 OF PLATS, P.30) " 2781' SOUTH TO RAILROAD & 10.4' NORTH OF (M-2)"
- CHICAGO, KALAMAZOO, & SAGINAW RAILROAD CO.: 8 NOVEMBER, 1888 (L.1 OF PLATS, P.34) "405' NORTH OF C.K.&S. RAILROAD"
- COUNTY SURVEYOR RECORDS: WALTER HEATH 18-19, 1905 (L.3, P.102) "IRON STAKE SOUTH OF R.R. TRACK OVER CULVERT"
- LAND CORNER RECORDATION CERTIFICATE: #416, BY BRIAN REYNOLDS, P.S. #31602, "SET 'PK' NAIL IN PAVEMENT ON LINE AND PROPORTIONING HEATH'S DISTANCES BETWEEN M-1 AND M-3. DISTANCE TO CENTER OF SECTION 1 OCCUPATION CHECKS FAVORABLY WITH HEATH'S DISTANCE" U. POLE S30°W 42.82' U. POLE S35°E 49.86' U. POLE N60°W 66.55' CENTERLINE E. 2.75'

B. Description of corner evidence found and/or method applied in restoring or reestablishing corner:

FOUND "PK" NAIL AS DESCRIBED IN LCRC #416. ACCEPTED THIS AS BEST AVAILABLE EVIDENCE OF CORNER POSITION. IT IS PHYSICALLY IMPOSSIBLE TO SET A MONUMENT IN THIS LOCATION, AS IT IS IN THE TRANSITION FROM HIGHWAY PAVEMENT TO THE RAILROAD RAIL CROSSING. SET REFERENCE MONUMENTS AS DESCRIBED IN PART "C".

C. Description of monument for corner and accessories established to perpetuate locating the position of the corner:  
NOT ABLE TO PLACE MONUMENT DUE TO THE RAILROAD LOCATION. WITNESSES TO "PK"


SET "PK" IN UTILITY POLE S30°W 42.82' SET "PK" IN UTILITY POLE S35°E 49.86'  
SET "PK" IN UTILITY POLE S50°W 66.55' CENTERLINE OF RAILROAD LIES NORTH 8.39'  
CENTERLINE OF NORTH-SOUTH BITUMINOUS ROAD SEAM LIES EAST 2.60'

REFERENCE MONUMENTS (CAPPED IRONS) AS FOLLOWS:

N53°38'35"E, 71.91'  
N45°01'24"W, 63.88'  
S54°43'07"W, 54.61'  
S48°27'00"E, 79.85'

M-3 LIES S02°30'45"W, 2638.91'  
M-1 LIES N02°30'45"E, 2793.80'

ACT 345 BARRY COUNTY REMONUMENTATION  
APPROVED BY PEER REVIEW AT A MEETING HELD ON  
10 July 95  
BR  
BRIAN REYNOLDS  
COUNTY SURVEYOR

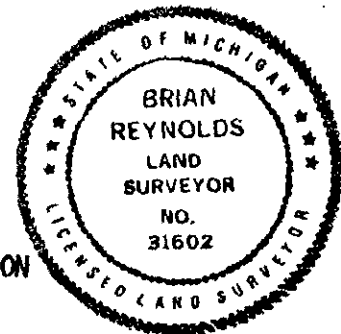

Signed by [Signature]  
Surveyor's Michigan License No 31602

Date DECEMBER 18, 1997