

SURVEY & REMONUMENTATION

FEB 17 1998

BARRY COUNTY REMONUMENTATION LAND CORNER RECORDATION CERTIFICATE Filing Requirement of Act 74, Mich. P.A. 1970

SECTION

For corners in

Barry (County)

Located in: Irving Township

Corner Code #



2671

Page: 1 of 2 01/02/1998 07:49A

Sandy Schondelmayer - Barry Co. LORCR

1. Public Land Survey

T	4N	R	9W	M-1
T		R		
T		R		
T	4N	R	8W	A-1
S		R		
S		R		
S		R		
S		R		

Carlton Township

2. Property Controlling in Section

3. Miscellaneous Property in Sec.

4. Lot No. _____, Recorded Plat _____
5. Private Claims _____

Register of Deeds Stamp & File Number

T4N, R8W							T4N, R9W						
A	B	C	D	E	F	G	H	I	J	K	L	M	
1													
2	6		5		4		3		2		1		
3													
4	7		8		9		10		11		12		
5													
6	18		17		16		15		14		13		
7													
8	19		20		21		22		23		24		
9													
10	30		29		28		27		26		25		
11													
12	31		32		33		34		35		36		
13													

I, Robert Jonker, in a field survey on Dec. 5, 1997 do hereby state that under requirements of P.A. 74, Michigan P.A. of 1970, the corner points mentioned in lines 1 and 2 above were in conformance with regulations and rules therefore as required in the current manual of survey instructions of the United States Department of the Interior, Bureau of Land Management or by a decree of a Court of Law and /or that the corner points mentioned in lines 3, 4 and 5 above were in conformance with the rules of the Michigan Board of Land Surveyors or by a Decree of a Court of Law; established, re-established, monumented, recovered, found as expressed below:

NOTE: Not more than 2 corners, all in the same town and range, may be recorded on this certificate.

A. Description of original monument and accessories and/or subsequent restoration:

- 3LO - 1826, L. Lyon D.S. L.C.R.C. #002 - 1971 Bill Rogers
- Beech 22 - N35W 33 Nothing listed in part "A" or "B"
- DO 18 - S43 1/2 E 39 Didn't say what was at corner
- 895 - Bateman N45°E spk - p.pole 37'
- 7d.-put iron & brick N45°W spk - 18" Osage Orange 32.9'
- 45 1/2 E 77', 15" Apple Center of U.S.G.S. B.M. S45°W 42.65'
- 37W, 33 2/3, 15" Mulberry Road Comm. - 1971
- Same as Bill Rogers (above)

See over for L.C.R.C.'s from Kent County 1131, 1715, 7002 & 9603-A & B

B. Description of corner evidence found and/or method applied in restoring or reestablishing corner:


Found Kent County Monument (Harrison) by witnesses listed for L.C.R.C. #9603-A & B

ACT 345 BARRY COUNTY REMONUMENTATION APPROVED BY PEER REVIEW AT A MEETING HELD ON

8 Dec. 97 [Signature] COUNTY SURVEYOR

C. Description of monument for corner and accessories established to perpetuate locating the position of the corner:

- Harrison Mon. S60°W 56.52'
- Kent Co. Remon nail & tag on NW side P.Pole N33°W 39.10'
- Kent Co. Remon nail & tag on N side G.Pole N44°E 36.90'
- Kent Co. Remon nail & tag on SE side P.Pole S63°E 48.3'
- C/L base of street sign post S19°W 63.24'
- Top of NW cor. steel guard rail post
- @ C/L "X"

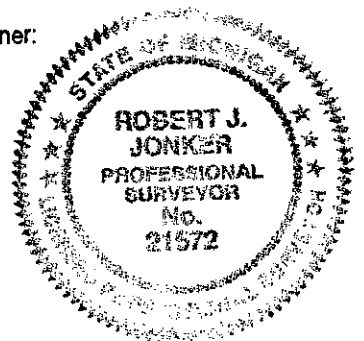

Signed by [Signature] Robert J. Jonker
Surveyor's Michigan License No. 21572

Date Dec. 8, 1997

SURVEY &
REMONUMENTATION

FEB 17 1998

SECTION



2671

Page: 2 of 2
01/02/1998 07:49A

Sandy Schondelmayer - Barry Co. LCRCR

NOTE: M-1, T4N, R9W, is common with M-13, T5N, R9W.
The following L.C.R.C.'s have been recorded in Kent County for this corner.

LCRC #1131, 1978, Medema, VanKooten & Assoc.
Found 1½" round iron that agreed with the Kent Co. Wit. map.
Part "C" - took wit.
Spike W side 28" Oak SSE 131.55'
Spike SW side 26" Mulberry NW 33.46'
PK SE side p & t pole NE 36.88'

LCRC #1715, Williams & Works, 1981 - Also LCRC #1131 is listed
Part "A" - K.C.R.C. wit. map - 1944
18" Mulberry NW 33.05'
Cor. steel fe. post SE 27.2'
18" Elm ESE 123.9'
16" Oak SSE 130.75'
Cor. fe. post SW 36.6'

Part "B" - Found 1½" round iron & shear blades in stone pile by some of the wit.
listed in part "A" above.

Part "C" - Set K.C. Mon. & took wit.
Nail & K.C. Remon tag in SW side 24" Mulberry N40°W 33.39'
Nail & K.C. Remon tag in W side 31" Oak S10°E 131.54'
Nail & K.C. Remon tag in SE side 18" Pear S55°W 118.98'
Nail & K.C. Remon tag in S side 6" Maple N60°W 58.56'
Nail & K.C. Remon tag in E side 27" Mulberry N10°W 87.55'
Nail & K.C. Remon tag in W side 8" Cedar N40°E 40.75'
Nail & K.C. Remon tag in N side 12" Maple S80°E 126.13'
Set Mon. 3" under surface of gravel road N-S & E-W

LCRC #7002 - 1994 - Bill Byl
Part "A" - wit. listed in LCRC #1715
Part "B" - Found K.C. Mon.
Part "C" - took new wit.
Set nail & KC Remon tag SW side 32" Mulberry N40°W 33.39'
Nail & KC remon tag W side 31" Oak stump S10°E 131.57'
Set nail & KC remon tag S side 12" Maple N60°W 58.5'
Set nail & KC Remon tag E side 30" Mulberry N10°W 87.55'
Set nail & KC Remon tag W side 12" Cedar N40°E 40.75'
Set nail & KC Remon tag N side 18" Maple S80°E 126.13'

LCRC #9603 - A & B, Fall - 1996, Jonker L.S.
Part "A" - wit. listed for LCRC #1131, 7002 & 1715
Part "B" - Spring of 1996 - took wit. prior to construction
Fall 1996, set new Harrison Mon. by construction witnesses
Part "C" - Harrison Mon.
Kent Co. remon nail & tag on NW side P.Pole S60°W 56.52'
Kent Co. remon nail & tag on N side G.Pole N33°W 39.10'
Kent Co. remon nail & tag on SE side P.Pole N44°E 36.90'
C/L base of street sign post S63°E 48.3'
Top of NW cor. steel guard rail post S19°W 63.24'
@ C/L "x"