SURVEY & REMONUMENTATION
OCT 27 1994
COMMISSION

STATE OF MICHIGAN
COUNTY OF BARRY
RECEIVED FOR RECORD
SEP 26 11 21 AM '94
Sandy Schondelmayer
REGISTER OF DEEDS

BARRY COUNTY REMONUMENTATION
LAND CORNER RECORDATION CERTIFICATE
Filing Requirement of Act 74, Mich. P.A. 1970

002216

Register of Deeds Stamp & File Number

For corners in BARRY (County)

	Located In:	Corner Code #:
1. Public Land Survey	T4N R8W	A-5
CARLTON TOWNSHIP	T ___ R ___	
SW COR SECTION 7	T ___ R ___	
NW COR SECTION 18	T ___ R ___	
2. Property Controlling	S ___ T ___ R ___	
in Section	S ___ T ___ R ___	
3. Miscellaneous	S ___ T ___ R ___	
Property in Sec.	S ___ T ___ R ___	

4. Lot No. _____, Recorded Plat _____
5. Private Claims _____

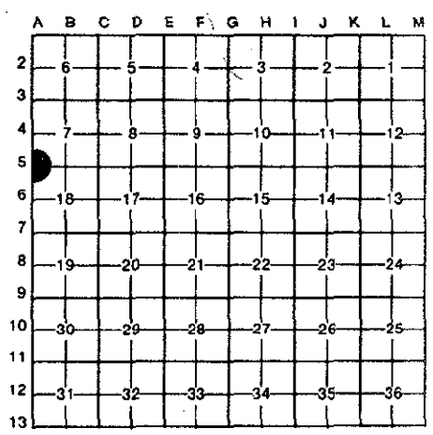

I, BRIAN REYNOLDS, in a field survey on 12 JULY, 19 94, do hereby certify that under requirements of P.A. 74, Michigan P.A. of 1970, the corner points mentioned in lines 1 and 2 above were in conformance with regulations and rules therefore as required in the current manual of survey instructions of the United States Department of the Interior, Bureau of Land Management or by a decree of a Court of Law and/or that the corner points mentioned in lines 3, 4 and 5 above were in conformance with the rules of the Michigan Board of Land Surveyors or by a Decree of a Court of Law; established, re-established, monumented, re-monumented, recovered, found as expressed below:

NOTE: Not more than 4 corners, all in the same town and range, may be recorded on this certificate.

A. Description of original monument and accessories and/or subsequent restoration:

1. GENERAL LAND OFFICE : SYLVESTER SIBLEY D. S., c. 1830 (R8W, PG. 167)
A. BEECH 6 S46E 36
Do. 10 N28E 22

2. NO OTHER HISTORICAL DATA OF RECORD COULD BE FOUND FOR THIS CORNER. NOTHING IN ROAD COMMISSION OR COUNTY SURVEYOR NOTES.

3. PRIVATE NOTES OF SURVEY BY BURT WICKHAM, P.S. #17639, SECTION 18, c. 1992. IRON FOUND, SHOWN ON SECTION BREAKDOWN DATA, BUT APPARENTLY NOT WITNESSED.

B. Description of corner evidence found and/or method applied in restoring or reestablishing corner:

FOUND 1/2" UNCAPPED IRON DESCRIBED BY WICKHAM, CONFIRMED WITH SECTION MEASUREMENTS. IT APPEARS THAT THE DISTANCE DATA RECITED IN GLO NOTES ARE GROSSLY IN ERROR, AS TO BOTH THE CLOSING DISTANCE AND FALLING BETWEEN STANDARD AND CLOSING CORNERS (CLOSING 1/2 MILE 2448.60' GLO, 2478.08' MEASURED; FALLING 34.98' GLO, 126.86 MEAS.) CORNER APPEARS TO HAVE BEEN ESTABLISHED BY INTERSECTING THE PROJECTED LINE FROM C-5 THROUGH B-5 WITH THE RANGE LINE DEFINED BY M-4 AND M-5. T4N,R9W. SECTION MEASUREMENTS CONFIRM THIS.

ACCEPTED FOUND IRON AS BEST AVAILABLE EVIDENCE OF CORNER POSITION.

REPLACED 1/2" UNCAPPED IRON WITH STANDARD BARRY COUNTY REMONUMENTATION MONUMENT.

ACT 345 BARRY COUNTY REMONUMENTATION
APPROVED BY PEER REVIEW AT A MEETING HELD ON
2 Aug. '94 BR
BRIAN REYNOLDS COUNTY SURVEYOR

C. Description of monument for corner and accessories established to perpetuate locating the position of the corner:

SET STANDARD BARRY COUNTY REMONUMENTATION IRON (3/4"X36" W/ALUMINUM CAP)
SET 40d NAIL W/REMON TAG IN S SIDE OF AN 18" OAK S86W 57.22'
SET 40d NAIL W/REMON TAG IN E SIDE OF A 10" MAPLE WEST 106.32'
SET 40d NAIL W/REMON TAG IN S SIDE OF A 3" POPLAR S88E 55.31'
SET 40d NAIL W/REMON TAG IN W SIDE OF A 48" OAK N15E 131.19
CORNER LIES 7.5' WEST OF EXISTING PAVEMENT

STATE OF MICHIGAN
BRIAN REYNOLDS
LAND SURVEYOR
NO. 31602
LICENSED LAND SURVEYOR

Signed by _____ Date SEPT 23, 1994
Surveyor's Michigan License No. 31602

FORM APPROVED BY MICHIGAN STATE BOARD OF LAND SURVEYORS, JAN. 28, 1971
REVISED MAY 14, 1975
REVISED JAN., 1983