

OCT 27 1994

COMMISSION

BARRY COUNTY REMONUMENTATION
LAND CORNER RECORDATION CERTIFICATE
Filing Requirement of Act 74, Mich. P.A. 1970

STATE OF MICHIGAN
COUNTY OF BARRY
RECEIVED FOR RECORD

SEP 26 11 21 AM '94

Sandy Schindelmarer
REGISTER OF DEEDS

For corners in

BARRY
(County)

Located In: Corner Code #

- | | | | |
|-------------------------|-------------|-------------|------------|
| 1. Public Land Survey | T <u>4N</u> | R <u>8W</u> | <u>A-8</u> |
| CARLTON TOWNSHIP | T | R | |
| W 1/4 COR SEC 19 | T | R | |
| | T | R | |
| 2. Property Controlling | S | T | R |
| in Section | S | T | R |
| 3. Miscellaneous | S | T | R |
| Property in Sec. | S | T | R |

002218

Register of Deeds Stamp & File Number

4. Lot No. _____, Recorded Plat _____
5. Private Claims _____

	A	B	C	D	E	F	G	H	I	J	K	L	M
2	6		5		4		3		2				
3													
4	7		8		9		10		11		12		
5													
6	18		17		16		15		14		13		
7													
8	19		20		21		22		23		24		
9													
10	30		29		28		27		26		25		
11													
12	31		32		33		34		35		36		

BRIAN REYNOLDS in a field survey on 12 JULY, 1994, do hereby certify that under requirements of P.A. 74, Michigan P.A. of 1970, the corner points mentioned in lines 1 and 2 above were in conformance with regulations and rules therefore as required in the current manual of survey instructions of the United States Department of the Interior, Bureau of Land Management or by a decree of a Court of Law and/or that the corner points mentioned in lines 3, 4 and 5 above were in conformance with the rules of the Michigan Board of Land Surveyors or by a Decree of a Court of Law; established, re-established, monumented, re-monumented, recovered, found as expressed below:

NOTE: Not more than 4 corners, all in the same town and range, may be recorded on this certificate.

A. Description of original monument and accessories and/or subsequent restoration:

1. THIS CORNER WAS NOT SET BY THE GENERAL LAND OFFICE.
2. NO HISTORICAL DATA, PUBLIC OR PRIVATE, COULD BE FOUND.

ACT 345 BARRY COUNTY REMONUMENTATION
APPROVED BY PEER REVIEW AT A MEETING HELD ON
2 Aug. '94
BRIAN REYNOLDS COUNTY SURVEYOR

B. Description of corner evidence found and/or method applied in restoring or reestablishing corner:

FOUND 1/2" IRON REPRESENTING M-8, T4N R9W. FOUND OCCUPATION FENCE APPARENTLY REPRESENTING 1/4 LINE. FOUND FENCES REPRESENTING CENTER OF SECTION. PROJECTED FENCE OCCUPATION FROM C-8 TO INTERSECT RANGE LINE DEFINED BY M-8 AND M-7, T4N R9W. POSITION THUS DEFINED WAS CONSISTENT WITH 1/8 LINE OCCUPATION SOUTH AND WITH RESTORED A-7 AND A-9.
DISTANCE TO A-7 2657.79'
DISTANCE TO A-9 2656.32'


CONDUCTED AN EXTENSIVE SEARCH FOR MONUMENTATION, AND FOUND NOTHING.

ACCEPTED POSITION THUS DETERMINED AS BEST METHOD OF RESTORING CORNER APPARENTLY SET BY A SURVEY (NOT OF RECORD) MANY YEARS AGO.

C. Description of monument for corner and accessories established to perpetuate locating the position of the corner:

SET STANDARD BARRY COUNTY REMONUMENTATION IRON (3/4"X36"W/ALUMINUM CAP)

- SET 40d NAIL W/REMON TAG IN NE SIDE OF A 32" MAPLE N38W 75.43'
- SET 40d NAIL W/REMON TAG IN W SIDE OF A 14" MAPLE S14W 144.83'
- SET 40d NAIL W/REMON TAG IN S SIDE OF A 12" ASH N87E 32.39'
- SET 40d NAIL W/REMON TAG IN SE SIDE OF A 4" MAPLE N34E 59.12'
- SE CORNER HOUSE #4545 N65W 81.03'
- IN LINE WITH OLD FENCE EAST

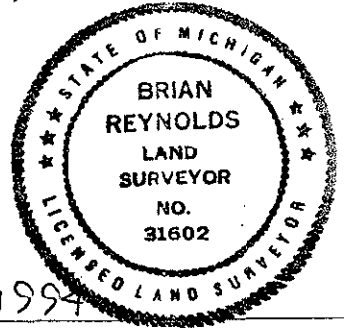

Signed by [Signature]

Date SEPT 23, 1994

Surveyor's Michigan License No. 31602