

STATE OF MICHIGAN
COUNTY OF BARRY

OCT 27 1994

**BARRY COUNTY REMONUMENTATION
LAND CORNER RECORDATION CERTIFICATE**
Filing Requirement of Act 74, Mich. P.A. 1970

STATE OF MICHIGAN
COUNTY OF BARRY
RECEIVED FOR RECORD

OCT 7 2 04 PM '94

Sandy Schondelmayer
REGISTER OF DEEDS

002235

Register of Deeds Stamp & File Number

For corners in COMMISSION
BARRY
(County)

Located In:

Corner Code ##

- | | | |
|--------------------------|-------------------------|------------|
| 1. Public Land Survey | T <u>4N</u> R <u>8W</u> | <u>B-6</u> |
| CARLTON TOWNSHIP | T _____ R _____ | _____ |
| CENTER SECTION 18 | T _____ R _____ | _____ |
| | T _____ R _____ | _____ |
| 2. Property Controlling | S _____ T _____ R _____ | _____ |
| in Section | S _____ T _____ R _____ | _____ |
| 3. Miscellaneous | S _____ T _____ R _____ | _____ |
| Property in Sec. | S _____ T _____ R _____ | _____ |

4. Lot No. _____, Recorded Plat _____
5. Private Claims _____

I, BRIAN REYNOLDS, in a field survey on 12 JULY, 1994, do hereby certify that under requirements of P.A. 74, Michigan P.A. of 1970, the corner points mentioned in lines 1 and 2 above were in conformance with regulations and rules therefore as required in the current manual of survey instructions of the United States Department of the Interior, Bureau of Land Management or by a decree of a Court of Law and/or that the corner points mentioned in lines 3, 4 and 5 above were in conformance with the rules of the Michigan Board of Land Surveyors or by a Decree of a Court of Law; established, re-established, monumented, re-monumented, recovered, found as expressed below:

NOTE: Not more than 4 corners, all in the same town and range, may be recorded on this certificate.

A	B	C	D	E	F	G	H	I	J	K	L	M
2	6	5	4	3	2	1						
3												
4	7	8	9	10	11	12						
5												
6	●	17	16	15	14	13						
7												
8	19	20	21	22	23	24						
9												
10	30	29	28	27	26	25						
11												
12	31	32	33	34	35	36						
13												

A. Description of original monument and accessories and/or subsequent restoration:

1. **NOT SET BY GENERAL LAND OFFICE. NO HISTORICAL DATA OF RECORD COULD BE FOUND FOR THIS CORNER.**

2. **PRIVATE NOTES: BURT WICKHAM, P.S. #17639, FROM SURVEY OF SECTION 18, c 1992.**
"SET 1/2" CAPPED REROD ON INTERSECTION OF 1/4 LINES"
WITNESSES TO CENTER OF SECTION 18 FROM PRIVATE NOTES BY BURT WICKHAM:
 FENCE LINE NORTH EAST (DISTANCE UNREADABLE)
 FENCE LINE E-W NORTH 6'
 NAIL S SIDE 8" MAPLE N45E 16.42'
 NAIL N SIDE 12" MAPLE CLUSTER N45W 13.75'
 STONE PILE N 45W 6'


B. Description of corner evidence found and/or method applied in restoring or reestablishing corner:

FOUND CAPPED REROD AND WITNESSES BY WICKHAM. TRAVERSED SECTION 18, TIED IN CENTER FROM SE CORNER. IRON COMPUTED TO BE 0.93' EAST AND 0.44' SOUTH OF INTERSECTION OF 1/4 LINES; HOWEVER TRAVERSE MISCLOSED BY 0.25' AND SIDESHOT TO CENTER WAS 3700'+, COMPUTED RESULTS SHOULD BE EVALUATED IN THAT CONTEXT. FENCES EAST AND NORTH INDICATE A PREVIOUS SURVEY (NOT OF RECORD) MANY YEARS AGO. ACCEPTED IRON AS PROPER RESTORATION OF CENTER OF SECTION.

REPLACED CAPPED REROD WITH STANDARD BARRY COUNTY REMONUMENTATION MONUMENT,
 ACT 345 BARRY COUNTY REMONUMENTATION
 APPROVED BY PEER REVIEW AT A MEETING HELD ON
2 AUGUST 1994
Brian Reynolds
 BRIAN REYNOLDS COUNTY SURVEYOR

C. Description of monument for corner and accessories established to perpetuate locating the position of the corner:
SET STANDARD BARRY COUNTY REMONUMENTATION IRON (3/4"X36"W/ALUMINUM CAP)

SET 40d NAIL W/REMON TAG IN SE SIDE OF A 5" CHERRY S50W 8.91'
FOUND 40d NAIL IN NW SIDE OF A 6" MAPLE N35E 22.35'
FOUND 40d NAIL IN NW SIDE OF A 9" MAPLE N45E 16.40'
FOUND 40d NAIL IN NE SIDE OF A 10" ASH N85W 13.79'
CORNER LIES 5' SOUTH OF AN E-W FENCE
CORNER IS IN LINE WITH FENCE TO THE NORTH

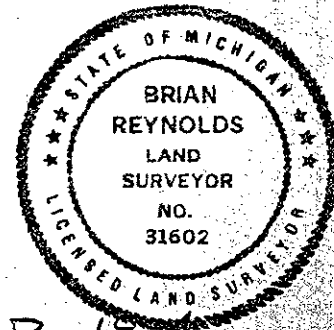

Signed by Brian Reynolds

Date OCT 7, 1994

Surveyor's Michigan License No. 31602