

OCT 27 1994

BARRY COUNTY REMONUMENTATION
LAND CORNER RECORDATION CERTIFICATE
Filing Requirement of Act 74, Mich. P.A. 1970

STATE OF MICHIGAN
COUNTY OF BARRY
RECEIVED FOR RECORD

SEP 26 11 21 AM '94

COMMISSION

For corners in
BARRY

(County)

Located In:

Corner Code #

1. Public Land Survey	T <u>4N</u> R <u>8W</u>	<u>B-7</u>
CARLTON TOWNSHIP	T _____ R _____	_____
S1/4 COR SECTION 18	T _____ R _____	_____
N 1/4 COR SECTION 19	T _____ R _____	_____
2. Property Controlling	S _____ T _____ R _____	_____
in Section	S _____ T _____ R _____	_____
3. Miscellaneous	S _____ T _____ R _____	_____
Property in Sec.	S _____ T _____ R _____	_____

Sandy Schondelmar
REGISTER OF DEEDS

002221

Register of Deeds Stamp & File Number

- 4. Lot No. _____, Recorded Plat _____
- 5. Private Claims _____

A	B	C	D	E	F	G	H	I	J	K	L	M
2	6	5	4	3	2	1						
3												
4	7	8	9	10	11	12						
5												
6	18	17	16	15	14	13						
7	●											
8	19	20	21	22	23	24						
9												
10	30	29	28	27	26	25						
11												
12	31	32	33	34	35	36						

I, **BRIAN REYNOLDS**, in a field survey on 12 JULY, 1994, do hereby certify that under requirements of P.A. 74, Michigan P.A. of 1970, the corner points mentioned in lines 1 and 2 above were in conformance with regulations and rules therefore as required in the current manual of survey instructions of the United States Department of the Interior, Bureau of Land Management or by a decree of a Court of Law and/or that the corner points mentioned in lines 3, 4 and 5 above were in conformance with the rules of the Michigan Board of Land Surveyors or by a Decree of a Court of Law; established, re-established, monumented, re-monumented, recovered, found as expressed below:

NOTE: Not more than 4 corners, all in the same town and range, may be recorded on this certificate.

A. Description of original monument and accessories and/or subsequent restoration:
1. GENERAL LAND OFFICE: SYLVESTER SIBLEY, D.S. DECEMBER, 1830.

A. BEECH 7 S5W 27 A. SUGAR 12 N37W 10

2. LAND CORNER RECORDATION CERTIFICATE #21: BY WM. HUME ROGERS, P.S. # 6197, 1972.

"RAIL ROAD SPIKE (FENCE NORTH)

TIES: DUE NORTH 22.40' TO FACE OF ANCHOR POST

POWER POLE N65W 63.50' TO SPIKE IN N SIDE

S45W 41.0' TO SPIKE IN N SIDE

S45E 45.00' TO SPIKE IN N SIDE OF A 10" WILD CHERRY"

3. ACT 132 SURVEY BY WM. HUME ROGERS, LIBER 1 OF SURVEYS, PAGE 20, RECITES SAME WITNESSES AS LCRC #21, EXCEPT THE WITNESS S45W IS CLARIFIED AS AN 8" ELM

4. ROAD COMMISSION WITNESS BOOK RECITES WITNESSES AND MONUMENT IDENTICAL TO LCRC #21.

B. Description of corner evidence found and/or method applied in restoring or reestablishing corner:

FOUND RAILROAD SPIKE AND TWO OF ROGERS WITNESSES (POWER POLE NW AND CHERRY).

ACCEPTED AS PERPETUATION OF CORNER POSITION.

REPLACED RAILROAD SPIKE WITH STANDARD BARRY COUNTY REMONUMENTATION MONUMENT.

ACT 345 BARRY COUNTY REMONUMENTATION
APPROVED BY PEER REVIEW AT A MEETING HELD ON

2 Aug. '94
BRIAN REYNOLDS

ISR
COUNTY SURVEYOR

C. Description of monument for corner and accessories established to perpetuate locating the position of the corner:

SET STANDARD BARRY COUNTY REMONUMENTATION IRON (3/4"X36" W/ALUMINUM CAP)


SET 40d NAIL W/REMON TAG IN E SIDE OF A 10" PINE N36W 57.09'

SET 40d NAIL W/REMON TAG IN NE SIDE OF A 4" CHERRY S31E 45.32'

SET 40d NAIL W/REMON TAG IN SE SIDE OF A POWER POLE S64W 73.40'

FOUND 40d NAIL W/CAP IN W SIDE OF A 12" PINE N12W 43.10'

FOUND 40d NAIL W/CAP IN NE SIDE OF A POWER POLE N65W 63.55

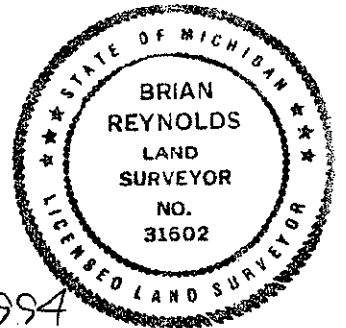

Signed by *Brian Reynolds*

Date SEPT 23, 1994

Surveyor's Michigan License No. 31602