

OCT 27 1994

COMMISSION

BARRY COUNTY REMONUMENTATION
LAND CORNER RECORDATION CERTIFICATE
Filing Requirement of Act 74, Mich. P.A. 1970

STATE OF MICHIGAN
COUNTY OF BARRY
RECEIVED FOR RECORD

SEP 26 11 21 AM '94

Sandy Schendelmayer
REGISTER OF DEEDS

002223

Register of Deeds Stamp & File Number

For corners in
BARRY

(County)

Located In:

Corner Code #

- 1. Public Land Survey T 4N R 8W Corner Code B-9
CARLTON TOWNSHIP T _____ R _____
S 1/4 COR SECTION 19 T _____ R _____
N 1/4 COR SECTION 30 T _____ R _____
- 2. Property Controlling S _____ T _____ R _____
in Section S _____ T _____ R _____
- 3. Miscellaneous S _____ T _____ R _____
Property in Sec. S _____ T _____ R _____

- 4. Lot No. _____, Recorded Plat _____
- 5. Private Claims _____

I, **BRIAN REYNOLDS**, in a field survey on **12 JULY**, 19 **94**, do hereby certify that under requirements of P.A. 74, Michigan P.A. of 1970, the corner points mentioned in lines 1 and 2 above were in conformance with regulations and rules therefore as required in the current manual of survey instructions of the United States Department of the Interior, Bureau of Land Management or by a decree of a Court of Law and/or that the corner points mentioned in lines 3, 4 and 5 above were in conformance with the rules of the Michigan Board of Land Surveyors or by a Decree of a Court of Law; established, re-established, monumented, re-monumented, recovered, found as expressed below:

NOTE: Not more than 4 corners, all in the same town and range, may be recorded on this certificate.

	A	B	C	D	E	F	G	H	I	J	K	L	M
2	6		5		4		3		2		1		
3													
4	7		8		9		10		11		12		
5													
6	18		17		16		15		14		13		
7													
8	19		20		21		22		23		24		
9													
10	30		29		28		27		26		25		
11													
12	31		32		33		34		35		36		
13													

A. Description of original monument and accessories and/or subsequent restoration:

- 1. **GENERAL LAND OFFICE : DEPUTY SURVEYOR SYLVESTER SIBLEY, c. 1830**
A. W. OAK 34 S39W 49
Do. 7 N51E 52

2. **NOTHING IN COUNTY SURVEYOR NOTES.**

3. **CORNER CARD FROM MICHIGAN STATE HIGHWAY DEPARTMENT: FENCE CORNER INDICATED BY PROPERTY OWNERS TO BE 1/4 CORNER (J. L. CORBIT PARTY 1957)**

B. Description of corner evidence found and/or method applied in restoring or reestablishing corner:

FOUND FENCE CORNER INDICATED BY MDOT CORNER CARD, FENCES RUNNING WEST AND NORTH, SEVERAL SMALL AND MEDIUM SIZED STONES SURROUNDING BASE OF FENCE POST. WOODEN FENCE POST (ABOUT 8"X 10") WAS ROTTED THROUGH AT BASE. REMOVED STONES SEARCHED FOR MONUMENTATION, FOUND NOTHING BUT ROTTED REMAINS OF FENCE POST BELOW GRADE. ACCEPTED ROTTED BASE OF WOOD FENCE POST SURROUNDED BY STONES AS THE BEST AVAILABLE EVIDENCE OF CORNER POSITION.

PLACED STANDARD BARRY COUNTY REMONUMENTATION MONUMENT AT CENTER OF BASE OF ROTTED FENCE POST SURROUNDED BY STONES.


ACT 345 BARRY COUNTY REMONUMENTATION
APPROVED BY PEER REVIEW AT A MEETING HELD

2 Aug. '94 BR
BRIAN REYNOLDS COUNTY SURVEYOR

C. Description of monument for corner and accessories established to perpetuate locating the position of the corner:

SET STANDARD BARRY COUNTY REMONUMENTATION IRON (3/4"X36" W/ALUMINUM CAP)

- SET 40d NAIL W/REMON TAG IN THE SE SIDE OF A 12" HICKORY N45E 37.12'**
- SET 40d NAIL W/REMON TAG IN THE E SIDE OF A 42" TWIN OAK S5E 21.42'**
- SET 40d NAIL W/REMON TAG IN THE S SIDE OF A 24" OAK N60W 35.47'**
- SET 40d NAIL W/REMON TAG IN THE W SIDE OF A 12" OAK N5E 21.05'**
- IRON IS IN LINE WITH FENCES TO THE NORTH AND WEST**
- IRON LIES 22.5' SOUTH OF A R/W FENCE RUNNING EAST**

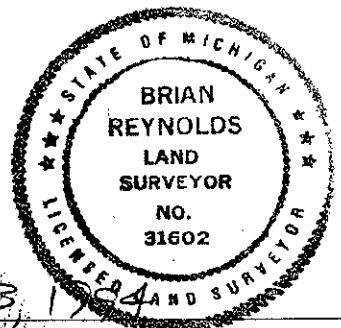

Signed by [Signature]

Date SEPT 23 1994

Surveyor's Michigan License No. 31602