

OCT 27 1994

BARRY COUNTY REMONUMENTATION
LAND CORNER RECORDATION CERTIFICATE
Filing Requirement of Act 74, Mich. P.A. 1970

STATE OF MICHIGAN
COUNTY OF BARRY
RECEIVED FOR RECORD

SEP 26 11 21 AM '94

COMMISSION

For corners in
BARRY

(County)

Located In:

Corner Code #

Sandy Schendelmayer
REGISTER OF DEEDS

1. Public Land Survey	T	<u>4N</u>	R	<u>8W</u>	<u>C-5</u>
CARLTON TOWNSHIP	T		R		
CORNER COMMON TO	T		R		
SECTIONS 7, 8, 17, 18	T		R		
2. Property Controlling	S		T		
in Section	S		T		
3. Miscellaneous	S		T		
Property in Sec.	S		T		

002224

Register of Deeds Stamp & File Number

- 4. Lot No. _____, Recorded Plat _____
- 5. Private Claims _____

A	B	C	D	E	F	G	H	I	J	K	L	M
2	6	5	4	3	2	1						
3												
4	7	8	9	10	11	12						
5												
6	13	17	16	15	14	13						
7												
8	19	20	21	22	23	24						
9												
10	30	29	28	27	26	25						
11												
12	31	32	33	34	35	36						
13												

I, **BRIAN REYNOLDS**, in a field survey on 12 JULY, 19 94, do hereby certify that under requirements of P.A. 74, Michigan P.A. of 1970, the corner points mentioned in lines 1 and 2 above were in conformance with regulations and rules therefore as required in the current manual of survey instructions of the United States Department of the Interior, Bureau of Land Management or by a decree of a Court of Law and/or that the corner points mentioned in lines 3, 4 and 5 above were in conformance with the rules of the Michigan Board of Land Surveyors or by a Decree of a Court of Law; established, re-established, monumented, re-monumented, recovered, found as expressed below:

NOTE: Not more than 4 corners, all in the same town and range, may be recorded on this certificate.

- A. Description of original monument and accessories and/or subsequent restoration:
 - 1. GENERAL LAND OFFICE: DEPUTY SURVEYOR SYLVESTER SIBLEY, DECEMBER, 1830
 - A. SUGAR 20 S59W 23 Do. S N19E 31
 - 2. NO MENTION OF THIS CORNER IN THE COUNTY SURVEYOR RECORDS.
 - 3. COUNTY ROAD COMMISSION WITNESS BOOK: "IRON PIPE
 - BRONZE PLUG SE SIDE 18" MAPLE S20W 67.77'
 - BRONZE PLUG S SIDE TELE POLE N67.30E 64'
 - NAIL AND CAP 30" POPLAR N29E 66.8'
 - 4. PRIVATE NOTES: BURT WICKHAM, P. S. #17639, FROM A SURVEY OF SECTION 18, c. 1992
 - "FOUND NAIL OVER 1" I. PIPE 4' BELOW ROAD SURFACE" WITS: NAIL IN P. POLE N30W 82.35'
 - NAIL IN P. POLE N15E 61.12'
 - NAIL IN 30" HICKORY S10E 118.72'
 - NAIL IN P. POLE S25W 91.99'
 - IN C/L "X" N-S, E-W ROADWAY

B. Description of corner evidence found and/or method applied in restoring or reestablishing corner:

FOUND PIPE AND WITNESSES AS RECITED BY WICKHAM.

ACCEPTED FOUND PIPE AS BEST AVAILABLE EVIDENCE OF CORNER POSITION.

REPLACED PIPE WITH STANDARD BARRY COUNTY REMONUMENTATION MONUMENT IN A MONUMENT BOX.

ACT 345 BARRY COUNTY REMONUMENTATION
APPROVED BY PEER REVIEW AT A MEETING HELD ON


2 Aug '94
BRIAN REYNOLDS

BR
COUNTY SURVEYOR

C. Description of monument for corner and accessories established to perpetuate locating the position of the corner:

SET STANDARD BARRY COUNTY REMONUMENTATION IRON (3/4"X36" W/ALUMINUM CAP) OVER EXISTING PIPE (4' BELOW GRADE) INSTALLED MONUMENT BOX IN BITUMINOUS ROADWAY.

- SET 40d NAIL W/REMON TAG IN SW SIDE OF A UTILITY POLE N32W 82.24'
- SET 40d NAIL W/REMON TAG IN NW SIDE OF A UTILITY POLE N32E 61.25'
- SET 40d NAIL W/REMON TAG IN W SIDE OF A 20" BLACK WALNUT S14E 118.56'
- SET 40d NAIL W/REMON TAG IN NW SIDE OF A 24" MAPLE S22W 66.92'
- SET 40d NAIL W/REMON TAG IN NW SIDE OF A 12" MAPLE N55E 70.50'
- CORNER LIES 0.3' WEST OF N-S C/L BITUMINOUS ROADWAY (NORTH BROADWAY)

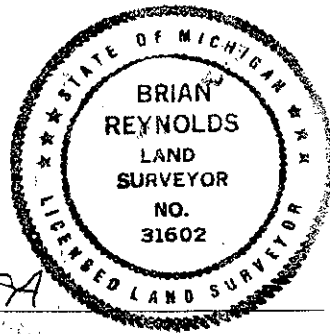

Signed by [Signature]

Date SEPT 23, 1994

Surveyor's Michigan License No. 31602