

OCT 27 1994

COMMISSION

BARRY COUNTY REMONUMENTATION  
LAND CORNER RECORDATION CERTIFICATE  
Filing Requirement of Act 74, Mich. P.A. 1970

STATE OF MICHIGAN  
COUNTY OF BARRY  
RECEIVED FOR RECORD

SEP 26 11 21 AM '94

Sandra Schendelmayer  
REGISTER OF DEEDS

002225

Register of Deeds Stamp & File Number

For corners in:

BARRY

(County)

Located In:

Corner Code #

- |                             |                         |            |
|-----------------------------|-------------------------|------------|
| 1. Public Land Survey       | T <u>4N</u> R <u>8W</u> | <u>C-6</u> |
| <b>CARLTON TOWNSHIP</b>     | T _____ R _____         | _____      |
| <b>E 1/4 COR SECTION 18</b> | T _____ R _____         | _____      |
| <b>W 1/4 COR SECTION 18</b> | T _____ R _____         | _____      |
| 2. Property Controlling     | S _____ T _____ R _____ | _____      |
| in Section                  | S _____ T _____ R _____ | _____      |
| 3. Miscellaneous            | S _____ T _____ R _____ | _____      |
| Property in Sec.            | S _____ T _____ R _____ | _____      |

4. Lot No. \_\_\_\_\_, Recorded Plat \_\_\_\_\_
5. Private Claims \_\_\_\_\_

**BRIAN REYNOLDS**

**12 JULY**

**94**

I, BRIAN REYNOLDS, in a field survey on 12 JULY, 1994, do hereby certify that under requirements of P.A. 74, Michigan P.A. of 1970, the corner points mentioned in lines 1 and 2 above were in conformance with regulations and rules therefore as required in the current manual of survey instructions of the United States Department of the Interior, Bureau of Land Management or by a decree of a Court of Law and/or that the corner points mentioned in lines 3, 4 and 5 above were in conformance with the rules of the Michigan Board of Land Surveyors or by a Decree of a Court of Law; established, re-established, monumented, re-monumented, recovered, found as expressed below:

**NOTE: Not more than 4 corners, all in the same town and range, may be recorded on this certificate.**

	A	B	C	D	E	F	G	H	I	J	K	L	M
2	6		5		4		3		2		1		
3													
4	7		8		9		10		11		12		
5													
6	18		17		16		15		14		13		
7													
8	19		20		21		22		23		24		
9													
10	30		29		28		27		26		25		
11													
12	31		32		33		34		35		36		

A. Description of original monument and accessories and/or subsequent restoration:

- GENERAL LAND OFFICE: DEPUTY SURVEYOR SYLVESTER SIBLEY, DECEMBER 1830**  
A. TAMARACK 8 N71E 15 AN ELM 7 S59W 25
- NO MENTION OF THIS CORNER IN COUNTY SURVEYOR RECORDS, ROAD COMMISSION RECORDS, OR ANY OTHER PUBLIC RECORD.**
- PRIVATE NOTES: BURT WICKHAM, P. S. #17639, FROM SURVEY OF SECTION 18, c. 1992**  
"SET PK NAIL EQUIDISTANT AND ON LINE BETWEEN NE COR 18-4-8 AND SE COR 18-4-8".  
TOP-CENTER BELL CABLE PED. S30W 44.08'  
NAIL IN 10" SCRUB S45E 50.19'  
NAIL IN TELE POLE N15W 116.36'  
C/L BIT ROADWAY EAST 4.0'

B. Description of corner evidence found and/or method applied in restoring or reestablishing corner:

**FOUND PK NAIL AND WITNESSES BY WICKHAM. POSITION CONFORMS WITH VAGUE OCCUPATION LINE EAST.**

**ACCEPTED PK NAIL AS PROPER RESTORATION OF CORNER POSITION.**

**REPLACED PK NAIL WITH STANDARD BARRY COUNTY REMONUMENTATION MONUMENT INSIDE A MONUMENT BOX.**

ACT 343 BARRY COUNTY REMONUMENTATION  
APPROVED BY PEER REVIEW AT A MEETING HELD ON


2 Aug. '94  
BRIAN REYNOLDS

BR  
COUNTY SURVEYOR

C. Description of monument for corner and accessories established to perpetuate locating the position of the corner:

**SET STANDARD BARRY COUNTY REMONUMENTATION IRON (3/4"X36"W/ALUMINUM CAP) AND INSTALLED MONUMENT BOX**

- FOUND 40d NAIL IN N SIDE OF A 40" ELM S80W 79.73'**
- FOUND 40d NAIL IN SW SIDE OF A UTILITY POLE N15W 116.40'**
- FOUND 40d NAIL IN NE SIDE OF A 10" SCRUB S45E 50.22'**
- TOP CENTER OF A BELL TELEPHONE BOX S50W 44.08**
- IRON LIES 4' WEST OF C/L BITUMINOUS ROADWAY ( NORTH BROADWAY )**
- IRON IS IN LINE WITH VAGUE OCCUPATION TO THE EAST**

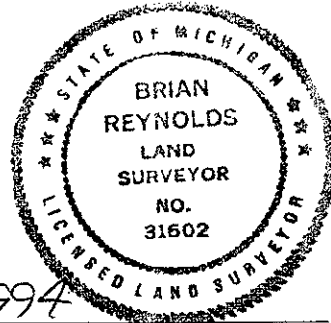

Signed by Brian Reynolds  
Surveyor's Michigan License No. 31602

Date SEPT 23, 1994