

OCT 27 1994

BARRY COUNTY REMONUMENTATION
LAND CORNER RECORDATION CERTIFICATE
Filing Requirement of Act 74, Mich. P.A. 1970

STATE OF MICHIGAN
COUNTY OF BARRY
RECEIVED FOR RECORD
SEP 26 11 21 AM '94

For corners in
BARRY
(County)

Located in:	Corner Code #
T <u>4N</u> R <u>8W</u>	<u>C-7</u>
T _____ R _____	_____
T _____ R _____	_____
T _____ R _____	_____
S _____ T _____ R _____	_____
S _____ T _____ R _____	_____
S _____ T _____ R _____	_____
S _____ T _____ R _____	_____

Sandra Schondelmayer
REGISTER OF DEEDS

002226

Register of Deeds Stamp & File Number

1. Public Land Survey
**CARLTON TOWNSHIP
CORNER COMMON TO
SECTIONS 17, 18, 19, 20**

2. Property Controlling
in Section

3. Miscellaneous
Property in Sec.

4. Lot No. _____, Recorded Plat _____
5. Private Claims _____

A	B	C	D	E	F	G	H	I	J	K	L	M
2	6	5	4	3	2	1						
3												
4	7	8	9	10	11	12						
5												
6	18	17	16	15	14	13						
7												
8	19	20	21	22	23	24						
9												
10	30	29	28	27	26	25						
11												
12	31	32	33	34	35	36						

I, **BRIAN REYNOLDS**, in a field survey on **12 JULY**, 19 **94**, do hereby certify that under requirements of P.A. 74, Michigan P.A. of 1970, the corner points mentioned in lines 1 and 2 above were in conformance with regulations and rules therefore as required in the current manual of survey instructions of the United States Department of the Interior, Bureau of Land Management or by a decree of a Court of Law and/or that the corner points mentioned in lines 3, 4 and 5 above were in conformance with the rules of the Michigan Board of Land Surveyors or by a Decree of a Court of Law; established, re-established, monumented, re-monumented, recovered, found as expressed below:

NOTE: Not more than 4 corners, all in the same town and range, may be recorded on this certificate.

A. Description of original monument and accessories and/or subsequent restoration:

- GENERAL LAND OFFICE: DEPUTY SURVEYOR SYLVESTER SIBLEY, c. 1830
A. BEECH 6 N58E 12 AN IRONWOOD 6 S57W 15
- COUNTY ROAD COMMISSION: JANUARY 15, 1971
NAIL AND CAP IN 30" ELM S53.30E 53.02' WOOD COR. POST N45W 47.4'
NAIL AND CAP IN 15" WALNUT N49W 41.3' IRON COR. POST S45E 39.5'
NAIL AND CAP IN 15" MAPLE N49.30E 49.69' T. POLE S30W 46.3'
- LAND CORNER RECORDATION CERTIFICATE: #21, WM. HUME ROGERS, P. S. #6197, 1972. "NAIL OVER 1 1/2" IRON IN PAVEMENT"
TIES: 15" MAPLE N49.30E 49.65' SPIKE IN POWER POLE S47E 65.00'
SPIKE IN E. SIDE TELE CABLE POLE S40W 49.00' SW CORNER CONC PORCH ON HOUSE N49E 83.5'
- ACT 132 SURVEYS, LIBER 1, PAGE 20, AND LIBER 1, PAGE 29, BY WM. HUME ROGERS RECITE SAME WITNESSES AS LCRC #21.
- UNRECORDED SURVEY BY KING & CARR INC., BRIAN REYNOLDS AS CREW CHIEF, JANUARY 1984.
"NAIL OVER PIPE" P. POLE S36W 49.05' P. POLE S51E 65.00'
22" MAPLE N58E 49.14' ON C/L CARLTON CENTER ROAD, 2'+ - W. OF C/L BROADWAY

B. Description of corner evidence found and/or method applied in restoring or reestablishing corner:

**FOUND 1 1/2" IRON PIPE IN PAVEMENT. EXCAVATED AND FOUND ANOTHER 1 1/2" IRON PIPE 3' BELOW ROAD SURFACE DIRECTLY UNDERNEATH PIPE AT SURFACE. ALSO FOUND SEVERAL WITNESSES TO CONFIRM POSITION.
REPLACED 1 1/2" IRON PIPE WITH STANDARD BARRY COUNTY REMONUMENTATION MONUMENT INSIDE OF A MONUMENT BOX.**


ACT 345 BARRY COUNTY REMONUMENTATION
APPROVED BY PEER REVIEW AT A MEETING HELD ON

2 Aug. '94 BR
BRIAN REYNOLDS COUNTY SURVEYOR

C. Description of monument for corner and accessories established to perpetuate locating the position of the corner:

SET STANDARD BARRY COUNTY REMONUMENTATION IRON (3/4"X36" W/ALUMINUM CAP) AND INSTALLED MONUMENT BOX.

- SET 40d NAIL W/REMON TAG IN NE SIDE OF A WOODEN FENCE CORNER POST N47W 53.09'
- SET 40d NAIL W/REMON TAG IN NW SIDE OF A UTILITY POLE S36W 48.77'
- FOUND NAIL WITH CAP IN SW SIDE OF A UTILITY POLE S54E 65.07'
- FOUND NAIL WITH CAP IN NW SIDE OF A 24" MAPLE N56E 49.62'
- CORNER LIES 2' WEST OF C/L BITUMINOUS ROADWAY (NORTH BROADWAY)
ON C/L CARLTON CENTER ROAD

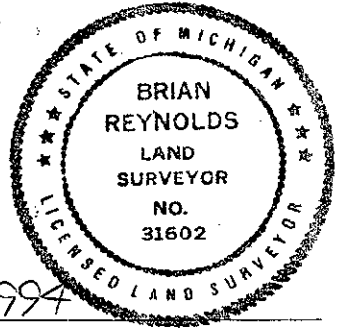

Signed by [Signature]
Surveyor's Michigan License No. 31602

Date SEPT 23, 1994