SURVEY & REMONUMENTATION

OCT 27 1994

COMMISSION

STATE OF MICHIGAN
COUNTY OF BARRY
RECEIVED FOR RECORD

SEP 26 11 21 AM '94

Sandy Schondelmayer
REGISTER OF DEEDS

002227

Register of Deeds Stamp & File Number

BARRY COUNTY REMONUMENTATION
LAND CORNER RECORDATION CERTIFICATE
Filing Requirement of Act 74, Mich. P.A. 1970

For corners in BARRY (County)

	Located In:	Corner Code ##
1. Public Land Survey	T 4N R 8W	C-8
CARLTON TOWNSHIP	T ___ R ___	
E 1/4 COR SEC 19	T ___ R ___	
	T ___ R ___	
2. Property Controlling	S ___ T ___ R ___	
in Section	S ___ T ___ R ___	
3. Miscellaneous	S ___ T ___ R ___	
Property in Sec.	S ___ T ___ R ___	

4. Lot No. _____ , Recorded Plat _____
5. Private Claims _____

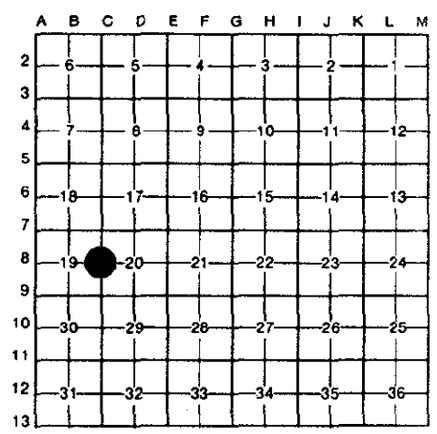

I, BRIAN REYNOLDS, in a field survey on 9 SEPT, 19 94, do hereby certify that under requirements of P.A. 74, Michigan P.A. of 1970, the corner points mentioned in lines 1 and 2 above were in conformance with regulations and rules therefore as required in the current manual of survey instructions of the United States Department of the Interior, Bureau of Land Management or by a decree of a Court of Law and/or that the corner points mentioned in lines 3, 4 and 5 above were in conformance with the rules of the Michigan Board of Land Surveyors or by a Decree of a Court of Law; established, re-established, monumented, re-monumented, recovered, found as expressed below:

NOTE: Not more than 4 corners, all in the same town and range, may be recorded on this certificate.

A. Description of original monument and accessories and/or subsequent restoration:

1. GENERAL LAND OFFICE : SYLVESTER SIBLEY D.S., 1830 (R8W, Pg. 165)
   AN ELM 8 S41W 32
   Do. 9 N63E 18
2. COUNTY SURVEYOR RECORDS: FRANK S. BOWEN , 22 MARCH 1878; FOUND STAKE, NEW BEARING (LIBER 1 OF SURVEYS, PAGE 227).
   MAPLE 12 N39E 54 1/2
   Do. 6 S27 1/2W 103
3. MICHIGAN STATE HIGHWAY DEPARTMENT: CONSUMERS POWER COMPANY.
   BOATSPIKE SET FROM OLD SURVEY (J.L. CORBIT PARTY , 1957 P. 12).
   CONCRETE R/W MARKER S88E 60.27'
   CONCRETE R/W MARKER S83W 60.41'
   MSHD 08012 M-43 1957, V.F.
4. NO OTHER RECORDED HISTORICAL INFORMATION FOR THIS CORNER COULD BE FOUND.

B. Description of corner evidence found and/or method applied in restoring or reestablishing corner:

FOUND 3/4" BOATSPIKE IN C/L BITUMINIUS ROAD (M-43)

ACCEPTED FOUND 3/4" BOATSPIKE AS BEST AVAILABLE EVIDENCE OF CORNER LOCATION.

REPLACED 3/4" BOATSPIKE WITH STANDARD BARRY COUNTY REMONUMENTATION MONUMENT IN MONUMENT BOX.

ACT 345 BARRY COUNTY REMONUMENTATION
APPROVED BY PEER REVIEW AT A MEETING HELD ON
2 Aug '94
BRIAN REYNOLDS — COUNTY SURVEYOR

C. Description of monument for corner and accessories established to perpetuate locating the position of the corner:

SET STANDARD BARRY COUNTY REMONUMENTATION IRON (3/4"X36"W/ALUMINUM CAP) AND INSTALLED MONUMENT BOX.

SET 40d NAIL W/REMON TAG IN N SIDE OF A 5" MAPLE CLUSTER S43E 53.59'
SET 40d NAIL W/REMON TAG IN SE SIDE OF A 6" MAPLE CLUSTER N80W 46.05'
TOP CENTER OF A 4"X 4" CONCRETE R/W MARKER S82W 60.39'
TOP CENTER OF A 4"X 4" CONCRETE R/W MARKER S89E 60.36
CORNER LIES ON C/L OF HIGHWAY M-43 AND IS IN LINE WITH TREE LINE TO THE EAST

STATE OF MICHIGAN
BRIAN REYNOLDS
LAND SURVEYOR
NO. 31602
LICENSED LAND SURVEYOR

Signed by _____ Date SEPT 23, 1994

Surveyor's Michigan License No. 31602

FORM APPROVED BY MICHIGAN STATE BOARD OF LAND SURVEYORS, JAN. 28, 1971
REVISED MAY 14, 1975
REVISED JAN., 1983