

APR 04 2000

BARRY COUNTY REMONUMENTATION

LAND CORNER RECORDATION CERTIFICATE
Filing Requirement of Act 74, Mich. P.A. 1970

SECTION

For Corners in BARRY (county) Located In: Corner Code #

1. Public Land Survey 1/4 CORNER COMMON TO SECTIONS 29 & 30 CARLTON TOWNSHIP T 4N R 8W C-10

2. Property Controlling in Section S T R S T R

3. Miscellaneous Property in Sec. S T R S T R

4. Lot No _____, Recorded Plat _____
5. Private Claims _____



2765

Page: 1 of 05/18/1999

Sandy Schondelmayer- Barry Co. LCRCR

Register of Deeds Stamp & File Number

I, Brian Reynolds, in a field survey on 10 AUGUST, 1998 do hereby certify that under requirements of P.A. 74, Michigan P.A. of 1970, the corner points mentioned in lines 1 and 2 above were in conformance with regulations and rules therefore as required in the current manual of survey instructions of the United States Department of the Interior, Bureau of Land Management or by a decree of a Court of Law and/or that the corner points mentioned in lines 3, 4, and 5 above were in conformance with the rules of the Michigan Board of Land Surveyors or by a Decree of a Court of Law; established, re-established, monumented, re-monumented, recovered, found as expressed below.

NOTE: Not more than 2 corners, all in the same town and range, may be recorded on this certificate.

A. Description of original monument and accessories and/or subsequent restoration:

- 1. GENERAL LAND OFFICE: SYLVESTER SIBLEY, D.S., 1830 (R8W, P. 163-164) A TAMERACK 8 N1E 1.21 Do. 6 N76E 1.06
2. HIGHWAY DEPARTMENT: J.L. CORBIT PARTY, 1957, (PROJECT 08012, P. 10) "PLACED BOAT SPIKE OVER 4" STAKE" 7.88' Lt OF STA. 990+11.52 FENCE POST S88°W 84.87' 26" ELM N87°E 82.94' CORN Fc. POST S88°W 33'
3. CONSUMERS POWER COMPANY: NO NAME OR DATE, SAME WITNESSES AS IN #2 ABOVE
4. PRIVATE NOTES OF SURVEY: BY BRIAN REYNOLDS, P.S. #31602, 04 MAY, 1992 (JOB #92384) "WITNESSES TO R.R. SPIKE I MON. BOX" "PK" NAIL IN TOP OF NORTHERNMOST WOOD GUARD RAIL POST N30°W 30.41' C/L TELE RISER N50W 50.28' 30" OAK N85°E 68.13' C/L ROAD EAST 8.73'

*** NO OTHER HISTORICAL DATA, PUBLIC OR PRIVATE, AVAILABLE FOR THIS CORNER ***

B. Description of corner evidence found and/or method applied in restoring or reestablishing corner:

FOUND BOAT SPIKE IN MONUMENT BOX & WITNESSES RECITED IN 2, 3 & 4 "A" ABOVE EXCEPT FENCE POST WITNESSES IN #2. ACCEPTED AS BEST AVAILABLE EVIDENCE OF CORNER POSITION.

C. Description of monument for corner and accessories established to perpetuate locating the position of the corner:

SET STANDARD BARRY COUNTY REMONUMENTATION MONUMENT (3/4" X 36" IRON) WITH ALUMINUM CAP. FOUND NAIL IN THE TOP CENTER OF THE NORTHERNMOST GUARD RAIL POST N37°W 30.35' SET 20d NAIL W/PLASTIC TAG IN THE TOP CENTER OF A FENCE CORNER POST N88°W 52.78' SET 20d NAIL W/PLASTIC TAG IN THE SOUTHEAST SIDE OF A 30" POPLAR N85°E 68.14' FOUND NAIL IN THE TOP CENTER OF A GUARD RAIL POST N85°W 12.93' FOUND NAIL IN THE SOUTH SIDE OF A 6" ASH S79°W 31.94' SET 1/2" CAPPED IRON ("REYNOLDS 31602") EAST 67.89' 8' +/- WEST OF PAINTED NORTH-SOUTH CENTERLINE IN LINE WITH FENCES EAST-WEST


Grid table with columns A-M and rows 1-13. Cell 10,29 contains a dot.

ACT 345 BARRY COUNTY REMONUMENTATION APPROVED BY PEER REVIEW AT A MEETING HELD ON

12 Jan '98

BRIAN REYNOLDS

COUNTY SURVEYOR

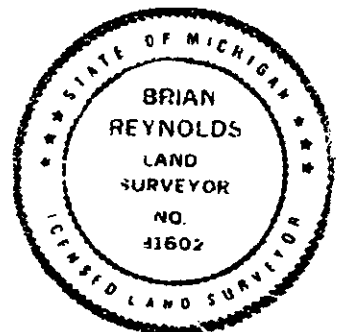

Signed by [Signature]

Surveyor's Michigan License No. 31602

Date MAY 18, 1999