

SURVEY & REMONUMENTATION **BARRY COUNTY REMONUMENTATION**

FEB 09 1998

**LAND CORNER RECORDATION CERTIFICATE**  
Filing Requirement of Act 74, Mich. P.A. 1970

For Corners in SECTION Located In: Corner Code #  
BARRY  
(county)

1. Public Land Survey T 4N R 8W D-9  
 1/4 CORNER COMMON TO T \_\_\_\_\_ R \_\_\_\_\_  
 SECTIONS 20 & 29 T \_\_\_\_\_ R \_\_\_\_\_  
 CARLTON TOWNSHIP T \_\_\_\_\_ R \_\_\_\_\_
2. Property Controlling S \_\_\_\_\_ T \_\_\_\_\_ R \_\_\_\_\_  
 in Section S \_\_\_\_\_ T \_\_\_\_\_ R \_\_\_\_\_
3. Miscellaneous S \_\_\_\_\_ T \_\_\_\_\_ R \_\_\_\_\_  
 Property in Sec. S \_\_\_\_\_ T \_\_\_\_\_ R \_\_\_\_\_
4. Lot No \_\_\_\_\_, Recorded Plat \_\_\_\_\_
5. Private Claims \_\_\_\_\_



**2751**  
Page: 1 of 1  
12/17/1998 12:35P

Register of Deeds Stamp & File Number

I, **Brian Reynolds**, in a field survey on 12 Jan. 98 do hereby certify that under requirements of P.A. 74, Michigan P.A. of 1970, the corner points mentioned in lines 1 and 2 above were in conformance with regulations and rules therefore as required in the current manual of survey instructions of the United States Department of the Interior, Bureau of Land Management or by a decree of a Court of Law and/or that the corner points mentioned in lines 3, 4, and 5 above were in conformance with the rules of the Michigan Board of Land Surveyors or by a Decree of a Court of Law; established, re-established, monumented, re-monumented, recovered, found as expressed below.

	A	B	C	D	E	F	G	H	I	J	K	L	M
1													
2	6		5		4		3		2		1		
3													
4	7		8		9		10		11		12		
5													
6	18		17		16		15		14		13		
7													
8	19		20		21		22		23		24		
9													
10	30		29		28		27		26		25		
11													
12	31		32		33		34		35		36		
13													

**NOTE: Not more than 2 corners, all in the same town and range, may be recorded on this certificate.**

A. Description of original monument and accessories and/or subsequent restoration:


GENERAL LAND OFFICE: SYLVESTER SIBLEY, D. S., 1830, "A. W. ASH 8 S80E 17 Do. 8 N68 1/2W 25"  
 COUNTY SURVEYOR FRANK S. BOWEN, 22 MARCH 1878, "BY OLD BEARINGS, NEW ONE BEECH 10 S52E 11"  
 UNRECORDED SURVEY BY BRIAN REYNOLDS, P.S. #31602, 29 APRIL 1991, FOUND 1" IRON PIPE  
 9" ASH NORTH 18.11' 10" MAPLE S15°W 15.22' 8" ASH S87°E 31.78' 8" CHERRY N45°E 31.74'  
 FENCES NORTH, SOUTH, EAST AND WEST

B. Description of corner evidence found and/or method applied in restoring or reestablishing corner:

**FOUND 1" x 5' IRON PIPE WITH 5/8" IRON INSIDE AS DESCRIBED BY REYNOLDS ABOVE. EXCAVATION REVEALED NO FURTHER EVIDENCE OF CORNER POSITION. FOUND PIPE/IRON IS CONSISTENT WITH OCCUPATION AND ADJACENT KNOWN CORNERS. ACCEPTED AS BEST AVAILABLE EVIDENCE OF CORNER POSITION. REPLACED FOUND PIPE / IRON WITH STANDARD BARRY COUNTY REMONUMENTATION MONUMENT.**

C. Description of monument for corner and accessories established to perpetuate locating the position of the corner:  
**SET STANDARD BARRY COUNTY REMONUMENTATION MONUMENT (3/4" X 36" IRON) WITH ALUMINUM CAP.  
 FOUND 20d NAIL IN THE EAST SIDE OF A 9" MAPLE NORTH 18.12'  
 FOUND 20d NAIL IN THE EAST SIDE OF AN 8" CHERRY N45°E 31.72'  
 FOUND 20d NAIL IN THE EAST SIDE OF A 10" MAPLE S15°W 15.30'  
 SET 20d NAIL W/PLASTIC TAG IN THE SOUTH SIDE OF A RAILROAD TIE FENCE POST N89°W 16.06'  
 SET 20d NAIL W/PLASTIC TAG IN THE SOUTHWEST ROOT OF A 5" MAPLE N45°W 32.79'  
 IN LINE WITH FENCES NORTH-SOUTH-EAST-WEST**

ACT 345 BARRY COUNTY REMONUMENTATION  
 APPROVED BY PEER REVIEW AT A MEETING HELD ON  
12 Jan. 98  
 BRIAN REYNOLDS COUNTY SURVEYOR

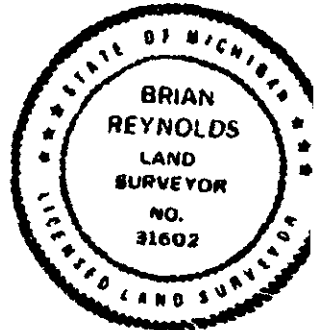

Signed by B-R  
 Surveyor's Michigan License No 31602

Date DEC 15, 1998