

BARRY COUNTY REMONUMENTATION

FEB 08 1999

LAND CORNER RECORDATION CERTIFICATE  
Filing Requirement of Act 74, Mich. P.A. 1970

SECTION

For Corners in BARRY Located In: Corner Code #  
(county)

1. Public Land Survey T 4N R 8W E-9  
CORNER COMMON TO T      R       
SECTIONS 20, 21, 28, & 29 T      R       
CARLTON TOWNSHIP T      R     



2750

Page: 1 of 1  
12/17/1998 12:35P

Sandy Schondelmayer - Barry Co. LCRCR

2. Property Controlling S      T      R       
in Section S      T      R     

Register of Deeds Stamp & File Number

3. Miscellaneous S      T      R       
Property in Sec. S      T      R     

4. Lot No     , Recorded Plat     

5. Private Claims     

I, **Brian Reynolds**, in a field survey on 12 JANUARY, 1998 do hereby certify that under requirements of P.A. 74, Michigan P.A. of 1970, the corner points mentioned in lines 1 and 2 above were in conformance with regulations and rules therefore as required in the current manual of survey instructions of the United States Department of the Interior, Bureau of Land Management or by a decree of a Court of Law and/or that the corner points mentioned in lines 3, 4, and 5 above were in conformance with the rules of the Michigan Board of Land Surveyors or by a Decree of a Court of Law; established, re-established, monumented, re-monumented, recovered, found as expressed below.

1	A	B	C	D	E	F	G	H	I	J	K	L	M
2		6		5		4		3		2		1	
3													
4		7		8		9		10		11		12	
5													
6		18		17		16		15		14		13	
7													
8		19		20		21		22		23		24	
9													
10		30		29		28		27		26		25	
11													
12		31		32		33		34		35		36	
13													

NOTE: Not more than 2 corners, all in the same town and range, may be recorded on this certificate.

A. Description of original monument and accessories and/or subsequent restoration:

GENERAL LAND OFFICE: SYLVESTER SIBLEY, D. S., 1830, "A. LYNN 22 S43W 11

A. BEECH 7 N75E 11"


NO OTHER HISTORICAL DATA, PUBLIC OR PRIVATE, COULD BE FOUND FOR THIS CORNER

B. Description of corner evidence found and/or method applied in restoring or reestablishing corner:

FOUND 1" UNCAPPED SOLID IRON NEAR CENTER OF NORTH-SOUTH GRAVEL ROAD, IN LINE WITH OCCUPATION EAST AND WEST. TRAVERSED ALL OF SECTION 29, FOUND THAT IRON IS CONSISTENT WITH OCCUPATION AND ADJACENT KNOWN CORNERS. ACCEPTED FOUND IRON AS BEST AVAILABLE EVIDENCE OF CORNER LOCATION.

C. Description of monument for corner and accessories established to perpetuate locating the position of the corner:

- SET STANDARD BARRY COUNTY REMONUMENTATION MONUMENT (3/4" X 36" IRON) WITH ALUMINUM CAP.
- SET 20d NAIL W/PLASTIC TAG IN THE SOUTH SIDE OF A 24" MAPLE N88°W 29.34'
- SET 20d NAIL W/PLASTIC TAG IN THE WEST SIDE OF A 26" MAPLE S19°E 89.68'
- SET 20d NAIL W/PLASTIC TAG IN THE SOUTH SIDE OF A 10" OAK N44°E 22.22'
- SET 20d NAIL W/PLASTIC TAG IN THE WEST SIDE OF A 16" TRIPLE OAK S82°E 21.15'
- SET 20d NAIL W/PLASTIC TAG IN THE NORTH SIDE OF A 16" MAPLE N58°E 21.97'

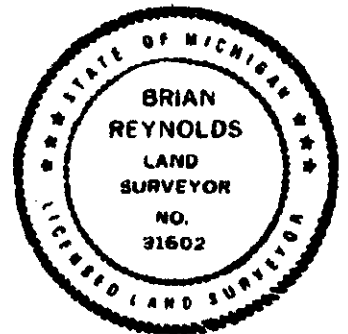

ACT 345 BARRY COUNTY REMONUMENTATION  
APPROVED BY PEER REVIEW AT A MEETING HELD ON

12 Jan. '98  
BRIAN REYNOLDS

ISR  
COUNTY SURVEYOR

Signed by Brian Reynolds  
Surveyor's Michigan License No 31602

Date DEC 15, 1998