

**SURVEY & REMONUMENTATION BARRY COUNTY REMONUMENTATION**

**AUG 13 1998**

**LAND CORNER RECORDATION CERTIFICATE**  
Filing Requirement of Act 74, Mich. P.A. 1970

**SECTION**

For Corners in BARRY Located In: \_\_\_\_\_ Corner Code # \_\_\_\_\_  
(county)



**2682**  
Page: 1 of 1  
04/23/1998 08:10A

1. Public Land Survey T 4N R 8W F-10  
**CENTER OF SECTION 28** T \_\_\_\_\_ R \_\_\_\_\_  
**CARLTON TOWNSHIP** T \_\_\_\_\_ R \_\_\_\_\_  
 T \_\_\_\_\_ R \_\_\_\_\_
2. Property Controlling S \_\_\_\_\_ T \_\_\_\_\_ R \_\_\_\_\_  
 in Section S \_\_\_\_\_ T \_\_\_\_\_ R \_\_\_\_\_
3. Miscellaneous S \_\_\_\_\_ T \_\_\_\_\_ R \_\_\_\_\_  
 Property in Sec. S \_\_\_\_\_ T \_\_\_\_\_ R \_\_\_\_\_
4. Lot No. \_\_\_\_\_, Recorded Plat \_\_\_\_\_
5. Private Claims \_\_\_\_\_

Sandy Schondelmayer - Barry Co. LCRCR

Register of Deeds Stamp & File Number \_\_\_\_\_

I, **Brian Reynolds**, in a field survey on **10 JUNE, 1997** do hereby certify that under requirements of P.A. 74, Michigan P.A. of 1970, the corner points mentioned in lines 1 and 2 above were in conformance with regulations and rules therefore as required in the current manual of survey instructions of the United States Department of the Interior, Bureau of Land Management or by a decree of a Court of Law and/or that the corner points mentioned in lines 3, 4, and 5 above were in conformance with the rules of the Michigan Board of Land Surveyors or by a Decree of a Court of Law; established, re-established, monumented, re-monumented, recovered, found as expressed below.

	A	B	C	D	E	F	G	H	I	J	K	L	M
2	6	5	4	3	2	1							
3													
4	7	8	9	10	11	12							
5													
6	18	17	16	15	14	13							
7													
8	19	20	21	22	23	24							
9													
10	30	29	28	27	26	25							
11													
12	31	32	33	34	35	36							
13													

**NOTE: Not more than 2 corners, all in the same town and range, may be recorded on this certificate.**

A. Description of original monument and accessories and/or subsequent restoration:

1. THIS CORNER WAS NOT SET BY THE GENERAL LAND OFFICE.
2. COUNTY ROAD COMMISSION: BICKNELL, 1950 (BARBER ROAD #40-50 F.B., P. 7) "SET SPIKE, DID NOT FIND CORNER"  
 00°17' Rt. OF STA. 88+78.7 IRON POST W. 24.2' TWIN CHERRY S60°E 67.9'  
 RD. SIGN S45°E 47.5' 24" WILD CHERRY N75°E 37.5'

\*\*\* NO OTHER RECORDED HISTORICAL INFORMATION AVAILABLE FOR THIS CORNER \*\*\*

B. Description of corner evidence found and/or method applied in restoring or reestablishing corner:

**FOUND NO EVIDENCE OF CORNER MONUMENTATION. FOUND NO WITNESSES FROM ROAD COMMISSION. EXCAVATION REVEALED NOTHING.**

**DID NOT ATTEMPT TO REESTABLISH ROAD COMMISSION POSITION, AS IT APPEARS TO BE A ROAD P.I. AND NOTHING MORE.**


**SET STANDARD BARRY COUNTY REMONUMENTATION MONUMENT AT INTERSECTION OF 1/4 LINES, IN LINE WITH OLD OCCUPATION (TREE/FENCE LINE) TO THE WEST & INSTALLED MONUMENT BOX.**

C. Description of monument for corner and accessories established to perpetuate locating the position of the corner:

**SET STANDARD BARRY COUNTY REMONUMENTATION MONUMENT (3/4" X 36" IRON) WITH ALUMINUM CAP.  
 SET 20d NAIL W/REMON TAG IN THE SOUTH SIDE OF A UTILITY POLE N88°W 60.45'  
 SET 20d NAIL W/REMON TAG IN THE NORTH SIDE OF A UTILITY POLE S68°E 144.19'  
 SET 20d NAIL W/REMON TAG IN THE SOUTH SIDE OF AN 8" MAPLE S75°W 81.32'  
 SET 20d NAIL W/REMON TAG IN THE NORTH SIDE OF A 10" MAPLE S46°W 109.09'  
 TOP CENTER OF THE NORTH END OF A 12" CORRUGATED METAL PIPE CULVERT UNDER DRIVEWAY S11°E 105.16  
 CORNER LIES 21'+/- NORTH OF CENTERLINE BITUMINOUS ROAD EAST 2.7'+/- EAST OF NORTH-SOUTH PAINTED CENTERLINE**

ACT 345 BARRY COUNTY REMONUMENTATION  
 APPROVED BY PEER REVIEW AT A MEETING HELD ON

14 July '97 ISR  
 BRIAN REYNOLDS COUNTY SURVEYOR

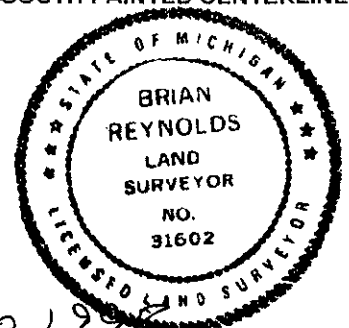

Signed by [Signature]  
 Surveyor's Michigan License No 31602

Date April 20, 1998