

SURVEY & REMONUMENTATION

AUG 22 1995

COMMISSION

BARRY COUNTY REMONUMENTATION

STATE OF MICHIGAN
COUNTY OF BARRY
RECEIVED FOR RECORD

LAND CORNER RECORDATION CERTIFICATE
Filing Requirement of Act 74, Mich. P.A. 1970

MAR 20 10 55 AM '95

Sandy Schondelmar
REGISTER OF DEEDS

For corners in
BARRY

(County)

Located In:

Corner Code #

1. Public Land Survey
**1/4 CORNER COMMON
TO SECTIONS 3 & 10
CARLTON TOWNSHIP**

T 4N R 8W

H-3

2. Property Controlling
in Section

S _____ T _____ R _____
S _____ T _____ R _____

3. Miscellaneous
Property in Sec.

S _____ T _____ R _____
S _____ T _____ R _____

002288

Register of Deeds Stamp & File Number

4. Lot No. _____, Recorded Plat _____
5. Private Claims _____

	A	B	C	D	E	F	G	H	I	J	K	L	M
2	6	5	4	3	2	1							
3								●					
4	7	8	9	10	11	12							
5													
6	18	17	16	15	14	13							
7													
8	19	20	21	22	23	24							
9													
10	30	29	28	27	26	25							
11													
12	31	32	33	34	35	36							
13													

I, **BRIAN REYNOLDS**, in a field survey on **15 APRIL**, 19 **1994**, do hereby certify that under requirements of P.A. 74, Michigan P.A. of 1970, the corner points mentioned in lines 1 and 2 above were in conformance with regulations and rules therefore as required in the current manual of survey instructions of the United States Department of the Interior, Bureau of Land Management or by a decree of a Court of Law and/or that the corner points mentioned in lines 3, 4 and 5 above were in conformance with the rules of the Michigan Board of Land Surveyors or by a Decree of a Court of Law; established, re-established, monumented, re-monumented, recovered, found as expressed below:

NOTE: Not more than 4 corners, all in the same town and range, may be recorded on this certificate.

A. Description of original monument and accessories and/or subsequent restoration:

- 1 **GENERAL LAND OFFICE: SYLVESTER SIBLEY, D.S., 1830 (R8W,P157), WEST CORRECTED 39.86 ELM 7 N14W 11 HICKORY 9 S25E 30**
- 2 **COUNTY ROAD COMMISSION: "STONE" 18" ELM S45E 48.0' 14" ELM SOUTH 30.4' 14" ELM S50W 51.5'**
- 3 **NO OTHER RECORDED HISTORICAL INFORMATION AVAILABLE FOR THIS CORNER**


B. Description of corner evidence found and/or method applied in restoring or reestablishing corner:

ALL ROAD COMMISSION WITNESS TREES REMOVED; HOWEVER, CLEAR DEPRESSIONS OF WHERE DECAYED TRUNKS OF TREES ONCE STOOD WERE IDENTIFIED. BEARING AND DISTANCE MEASUREMENTS FROM POINTS, THUS IDENTIFIED, CAME TOGETHER WITHIN 0.4' +/- EXCAVATED 2' X 2' AREA BELOW BITUMINOUS SURFACE AND DID NOT FIND STONE. SET STANDARD BARRY COUNTY REMONUMENTATION MONUMENT IN REFERENCE TO WITNESSES. INSTALLED MONUMENT BOX.

ACT 345 BARRY COUNTY REMONUMENTATION
APPROVED BY PEER REVIEW AT A MEETING HELD ON
3 May 94 BR
BRIAN REYNOLDS COUNTY SURVEYOR

C. Description of monument for corner and accessories established to perpetuate locating the position of the corner:

SET STANDARD BARRY COUNTY REMONUMENTATION MONUMENT (3/4"X36"W/ALUMINUM CAP) IN MONUMENT BOX
SET 40d NAIL W/REMON TAG IN THE NORTHWEST SIDE OF A 15" ELM S52°W 51.86'
SET 40d NAIL W/REMON TAG IN THE EAST SIDE OF A UTILITY POLE S2°E 216.33"
SET 40d NAIL W/REMON TAG IN THE NORTH SIDE OF A 10" ELM S75°E 112.29'
SET 40d NAIL W/REMON TAG IN THE SOUTH SIDE OF A 22" OAK N84°W 259.64'
5'+/- EAST OF WIRE FENCE NORTH
IN LINE WITH OCCUPATION TO THE SOUTH

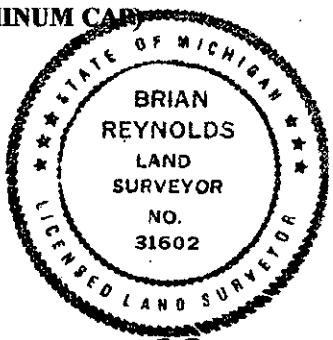

Signed by [Signature] Date MARCH 17, 1995
Surveyor's Michigan License No. 31602