

SURVEY & REMONUMENTATION

AUG 22 1995

COMMISSION

BARRY COUNTY REMONUMENTATION

STATE OF MICHIGAN COUNTY OF BARRY RECEIVED FOR RECORD

MAR 20 10 55 AM '95

LAND CORNER RECORDATION CERTIFICATE Filing Requirement of Act 74, Mich. P.A. 1970

Sandy Schondelmayer REGISTER OF DEEDS

For corners in BARRY

(County)

Located In: Corner Code #

Table with 3 columns: Description, T/R, Corner Code. Includes 'Public Land Survey CORNER COMMON TO SECTIONS 2 & 3 CARLTON TOWNSHIP ON TOWN LINE' and 'Property Controlling in Section'.

002289

Register of Deeds Stamp & File Number

4. Lot No. Recorded Plat 5. Private Claims

Grid table with columns A-M and rows 2-13. A circle is drawn around the intersection of column I and row 2.

I, BRIAN REYNOLDS, in a field survey on 15 APRIL 1994, do hereby certify that under requirements of P.A. 74, Michigan P.A. of 1970, the corner points mentioned in lines 1 and 2 above were in conformance with regulations and rules therefore as required in the current manual of survey instructions of the United States Department of the Interior, Bureau of Land Management or by a decree of a Court of Law and/or that the corner points mentioned in lines 3, 4 and 5 above were in conformance with the rules of the Michigan Board of Land Surveyors or by a Decree of a Court of Law; established, re-established, monumented, re-monumented, recovered, found as expressed below:

NOTE: Not more than 4 corners, all in the same town and range, may be recorded on this certificate.

A. Description of original monument and accessories and/or subsequent restoration:

- 1 GENERAL LAND OFFICE: SYLVESTER SIBLEY, D.S., 1830 (R8W,P153), NORTH 79.80 NORTH BOUNDARY 65 LINKS EAST OF POST SUGAR 8 S69W 27 Do. 12 S66E 56
2 COUNTY SURVEYOR RECORDS: LEE COBB, 1895 (L.2,PG.283), FOUND OLD STAKE. SET STONE 24X12X10 & BRICK
3 LAND CORNER RECORDATION CERTIFICATE: #337 BY ROBERT CARR, P.S. #20704, 10 NOV. 1981, "FOUND IRON PIPE AT SOUTHEAST CORNER SECTION 36,T5N, R8W. SET 1/2" IRON 42.90' EAST AS PER G.L.O. SURVEY." U-POLE S50E 79.50' U-POLE N05E 115.23' SE COR OLD SCHOOL N70W 101.55'
4 SURVEY BY ROBERT CARR, P.S. #20704, 31 MARCH, 1982(ACT 132 SURVEY, L.1, P.704) WITNESSES SAME AS IN 2 ABOVE
5 NO OTHER RECORDED HISTORICAL INFORMATION AVAILABLE FOR THIS CORNER


B. Description of corner evidence found and/or method applied in restoring or reestablishing corner:

FOUND IRON RECORDED BY CARR. CORRESPONDING STANDARD CORNER HAS BEEN REMONUMENTED 11'+/- EAST OF POSITION FOUND BY CARR. (INFORMATION PROVIDED BY MARINUS MULDER P.S. #25863). MEASURED GOVERNMENT JOG FROM REMONUMENTED IONIA COUNTY CORNER. EXCAVATED IN GRAVEL ROAD 3" BELOW SURFACE, FOUND TOP OF STONE BY COBB. EXCAVATED FURTHER, REMOVED STONE, FOUND LARGE QUANTITY OF BRICK AND CROCKERY. ACCEPTED STONE AS TRUE CORNER, DISREGARDED POSITION RECORDED BY CARR. REPLACED STONE WITH STANDARD BARRY COUNTY REMONUMENTATION MONUMENT

ACT 345 BARRY COUNTY REMONUMENTATION APPROVED BY PEER REVIEW AT A MEETING HELD ON

3 May '94 BRIAN REYNOLDS

BR COUNTY SURVEYOR

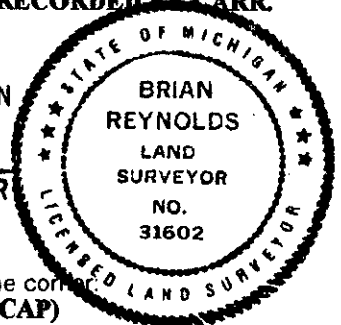

C. Description of monument for corner and accessories established to perpetuate locating the position of the corner: SET STANDARD BARRY COUNTY REMONUMENTATION MONUMENT (3/4"X36"W/ALUMINUM CAP)

- SET 40d NAIL W/REMON TAG IN THE WEST SIDE OF A POWER POLE N1°E 113.29'
SET 40d NAIL W/REMON TAG IN THE SOUTHWEST SIDE, SOUTHERLY TRUNK OF A 24" TWIN CHERRY N55°W 128.93'
SET 40d NAIL W/REMON TAG IN THE NORTHWEST SIDE, NORTH TRUNK OF AN 18" TWIN ASH S55°W 127.49'
SET 40d NAIL W/REMON TAG IN THE NORTHWEST SIDE OF A POWER POLE S38°W 87.06'
SET 40d NAIL W/REMON TAG IN THE SOUTHWEST SIDE OF A 4" ASH S42°E 59.66'
SOUTHWEST CORNER OF THE CONCRETE FOUNDATION OF OLD SCHOOL HOUSE N78°W 162.19'
IN LINE WITH CENTERLINE TO THE SOUTH

Signed by [Signature]

Date MARCH 17, 1995

Surveyor's Michigan License No. 31602