

REMONUMENTATION

AUG 22 1995

COMMISSION

BARRY COUNTY REMONUMENTATION

STATE OF MICHIGAN COUNTY OF BARRY RECEIVED FOR RECORD

MAR 20 10 55 AM '95

LAND CORNER RECORDATION CERTIFICATE Filing Requirement of Act 74, Mich. P.A. 1970

Sandy Schondelmarer REGISTER OF DEEDS

For corners in BARRY

(County)

Located In: Corner Code #

1. Public Land Survey 1/4 CORNER COMMON TO SECTIONS 2 & 3 CARLTON TOWNSHIP

Table with columns for Township (T), Range (R), and Section (S). Includes handwritten entries: 4N, 8W, I-2.

2. Property Controlling in Section 3. Miscellaneous Property in Sec.

4. Lot No. , Recorded Plat 5. Private Claims

002290

Register of Deeds Stamp & File Number

BRIAN REYNOLDS

15 APRIL

1994

I, BRIAN REYNOLDS, in a field survey on 15 APRIL, 1994, do hereby certify that under requirements of P.A. 74, Michigan P.A. of 1970, the corner points mentioned in lines 1 and 2 above were in conformance with regulations and rules therefore as required in the current manual of survey instructions of the United States Department of the Interior, Bureau of Land Management or by a decree of a Court of Law and/or that the corner points mentioned in lines 3, 4 and 5 above were in conformance with the rules of the Michigan Board of Land Surveyors or by a Decree of a Court of Law; established, re-established, monumented, re-monumented, recovered, found as expressed below:

NOTE: Not more than 4 corners, all in the same town and range, may be recorded on this certificate.

Grid table with columns A-L and rows 2-13. A black dot is present in the cell corresponding to column G and row 3.

A. Description of original monument and accessories and/or subsequent restoration:

- 1 GENERAL LAND OFFICE: SYLVESTER SIBLEY, D.S., 1830 (R8W, PG.152-153) ELM 11 S83E 20 B. ASH 9 S53W 22
2 LAND CORNER RECORDATION CERTIFICATE #337, BY ROBERT R. CARR, P.S. # 20704, 10 NOV, 1981, "SET 1/2" IRON ON SEC. LINE AT E.-W. 1/4 LINE OCCUPATION." 15.4' WEST OF C/L FRY RD. TELE. RISER N80W 5.7' 4" ELM S60E 55.52'
3 SURVEY BY ROBERT R. CARR, 31 MARCH, 1982, (ACT 132 SURVEY, L.1, PG. 704) WITNESSES SAME AS IN 2 ABOVE
4 NO OTHE RECORDED HISTORICAL INFORMATION AVAILABLE FOR THIS CORNER


B. Description of corner evidence found and/or method applied in restoring or reestablishing corner:

DISREGARDED CORNER SET BY CARR (SET IN LINE WITH FALSE CORNER AT I-1. SEE LAND CORNER RECORDATION CERTIFICATE FOR I-1). AFTER EXCAVATING FULL WIDTH OF ROAD AND FINDING NOTHING, SET ON LINE BETWEEN I-1 AND I-3 AT OCCUPATION EAST AND WEST. SET STANDARD BARRY COUNTY REMONUMENTATION MONUMENT.

ACT 345 BARRY COUNTY REMONUMENTATION APPROVED BY PEER REVIEW AT A MEETING HELD ON

3 May '94 BRIAN REYNOLDS

BR COUNTY SURVEYOR

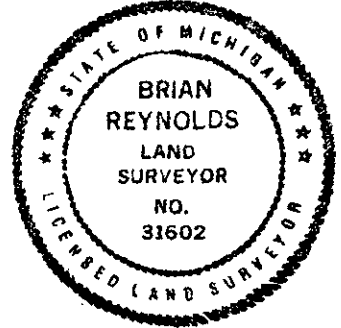

C. Description of monument for corner and accessories established to perpetuate locating the position of the corner:

- SET STANDARD BARRY COUNTY REMONUMENTATION MONUMENT (3/4"X36"W/ALUMINUM CAP)
SET 40d NAIL W/REMON TAG IN THE NORTHERLY SIDE OF AN 18" MAPLE S55°E 37.53'
SET 40d NAIL W/REMON TAG IN THE SOUTHWEST SIDE OF A 15" ELM S30°E 60.28'
SET 40d NAIL W/REMON TAG IN THE SOUTHEAST SIDE OF A 12" ELM S12°W 41.20'
SET 40d NAIL W/REMON TAG IN THE NORTHWEST SIDE, MAIN TRUNK OF A 36" DOUBLE MAPLE S23°W 23.97'
SET 40d NAIL W/REMON TAG IN THE WEST SIDE OF A 14" MAPLE N20°W 46.18'
TOP CENTER OF A TELEPHONE RISER N75°W 12.42'
10'+/- WEST OF NORTH - SOUTH CENTERLINE

Signed by

Handwritten signature of Brian Reynolds

Date

MARCH 17, 1995

Surveyor's Michigan License No.

31602