

SURVEY & REMONUMENTATION

NOV 04 1996

COMMISSION

BARRY COUNTY REMONUMENTATION

LAND CORNER RECORDATION CERTIFICATE
Filing Requirement of Act 74, Mich. P.A. 1970

STATE OF MICHIGAN
COUNTY OF BARRY
RECEIVED FOR RECORD

AUG 20 11 27 AM '96

Sandy Schondelmarer
REGISTER OF DEEDS

002384

Register of Deeds Stamp & File Number

For corners in
BARRY
(County)

Located In: Corner Code #

1. Public Land Survey	T	<u>4N</u>	R	<u>8W</u>	<u>1-9</u>
CORNER COMMON TO	T	_____	R	_____	_____
SECTIONS 22, 23, 26, 27	T	_____	R	_____	_____
CARLTON TOWNSHIP	T	_____	R	_____	_____
2. Property Controlling	S	_____	T	_____	_____
in Section	S	_____	T	_____	_____
3. Miscellaneous	S	_____	T	_____	_____
Property in Sec.	S	_____	T	_____	_____

4. Lot No. _____, Recorded Plat _____
5. Private Claims _____

A	B	C	D	E	F	G	H	I	J	K	L	M
2	6	5	4	3	2	1						
3												
4	7	8	9	10	11	12						
5												
6	13	17	16	15	14	13						
7												
8	19	20	21	22	23	24						
9												
10	30	29	28	27	26	25						
11												
12	31	32	33	34	35	36						
13												

I, **BRIAN REYNOLDS**, in a field survey on **13 FEBRUARY**, 19**95**, do hereby certify that under requirements of P.A. 74, Michigan P.A. of 1970, the corner points mentioned in lines 1 and 2 above were in conformance with regulations and rules therefore as required in the current manual of survey instructions of the United States Department of the Interior, Bureau of Land Management or by a decree of a Court of Law and/or that the corner points mentioned in lines 3, 4 and 5 above were in conformance with the rules of the Michigan Board of Land Surveyors or by a Decree of a Court of Law; established, re-established, monumented, re-monumented, recovered, found as expressed below:

NOTE: Not more than 4 corners, all in the same town and range, may be recorded on this certificate.

A. Description of original monument and accessories and/or subsequent restoration:

**GENERAL LAND OFFICE: SYLVESTER SIBLEY, D.S., 1830(R8W,P.149)
A. W. OAK 20 S.10E 25 Do. 18 N.20E. 14**


NO OTHER RECORDED HISTORICAL INFORMATION AVAILABLE FOR THIS CORNER.

B. Description of corner evidence found and/or method applied in restoring or reestablishing corner:

FOUND FLAT 1" X 18" IRON BAR WITH RIBBON AT APPROXIMATE PI OF CENTERLINE OF GRAVEL ROAD WITH TANGENTS WEST AND NORTH. BASED ON MEASUREMENTS AROUND SECTION 23, ACCEPTED AS A PERPETUATION OF THE CORNER, NOT OF RECORD.

ACT 345 BARRY COUNTY REMONUMENTATION
APPROVED BY PEER REVIEW AT A MEETING HELD ON

FEB 13 1995 BR
BRIAN REYNOLDS COUNTY SURVEYOR

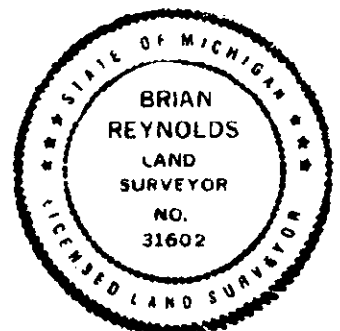

C. Description of monument for corner and accessories established to perpetuate locating the position of the corner:

- SET STANDARD BARRY COUNTY REMONUMENTATION MONUMENT (3/4"X36"W/ALUMINUM CAP)
- SET 40d NAIL W/PLASTIC CAP IN THE EAST SIDE OF A 12" HICKORY N20°W 3.84'
- SET 40d NAIL W/PLASTIC CAP IN THE SOUTHEAST SIDE OF AND 18" MAPLE N50°E 7.04'
- SET 40d NAIL W/PLASTIC CAP IN THE NORTH SIDE OF A 24" MAPLE S80°E 63.07'
- SET 40d NAIL W/PLASTIC CAP IN THE EAST SIDE NORTHEAST TRUNK OF A 6" MAPLE CLUSTER S10°W 21.77'
- SET 40d NAIL W/PLASTIC CAP IN THE EAST SIDE OF AN 8" MAPLE S35°W 35.81'
- SET 40d NAIL W/PLASTIC CAP IN THE EAST SIDE OF A 10" OAK S50°W 37.88'

Signed by [Signature]

Date AUGUST 16, 1996

Surveyor's Michigan License No. 31602