

SURVEY & REMONUMENTATION

AUG 22 1995

COMMISSION

BARRY COUNTY REMONUMENTATION

STATE OF MICHIGAN COUNTY OF BARRY RECEIVED FOR RECORD

MAR 20 10 55 AM '95

LAND CORNER RECORDATION CERTIFICATE Filing Requirement of Act 74, Mich. P.A. 1970

Sandy Schondelmarer REGISTER OF DEEDS

For corners in BARRY (County)

Located In: Corner Code #/

- 1. Public Land Survey NORTH 1/4 CORNER SECTION 2 CARLTON TOWNSHIP ON TOWN LINE T 4N R 8W J-1
2. Property Controlling in Section S T R
3. Miscellaneous Property in Sec. S T R

002292

Register of Deeds Stamp & File Number

- 4. Lot No. , Recorded Plat
5. Private Claims

Grid table with columns A-M and rows 2-13. Cell J-1 is shaded.


I, BRIAN REYNOLDS, in a field survey on 15 APRIL, 19 1994, do hereby certify that under requirements of P.A. 74, Michigan P.A. of 1970, the corner points mentioned in lines 1 and 2 above were in conformance with regulations and rules therefore as required in the current manual of survey instructions of the United States Department of the Interior, Bureau of Land Management or by a decree of a Court of Law and/or that the corner points mentioned in lines 3, 4 and 5 above were in conformance with the rules of the Michigan Board of Land Surveyors or by a Decree of a Court of Law; established, re-established, monumented, re-monumented, recovered, found as expressed below:

NOTE: Not more than 4 corners, all in the same town and range, may be recorded on this certificate.

- A. Description of original monument and accessories and/or subsequent restoration:
1 CORNER NOT SET BY GENERAL LAND OFFICE
2 COUNTY SURVEYOR RECORDS: LEE S. COBB, 1895 (L.2, PG. 283), "SET STONE 24X12X6 68 LNKS. EAST OF SECTION CORNER 35 CAMPBELL, 1/2 MILE = 40.06 CH. (I-1 TO J-1). IN LINE OF FENCE SET ON SURVEY BY JOHN CRESSEY."
3 NO OTHER RECORDED HISTORICAL INFORMATION AVAILABLE FOR THIS CORNER.

B. Description of corner evidence found and/or method applied in restoring or reestablishing corner: FOUND IRON REPRESENTING STANDARD CORNER SET BY MULDER P.S.#25863. IRON IS INCONSISTENT WITH JOG NOTED BY COBB. INTERSECTED TOWN LINE WITH 1/4 LINE OCCUPATION IN SECTION 2, FOUND POSITION TO BE CONSISTENT WITH COBB'S DISTANCE TO J-1. DID NOT EXCAVATE, AS CORNER POSITION FALLS IN ROAD CUT.

ACT 345 BARRY COUNTY REMONUMENTATION APPROVED BY PEER REVIEW AT A MEETING HELD ON 3 May '94 BRIAN REYNOLDS COUNTY SURVEYOR

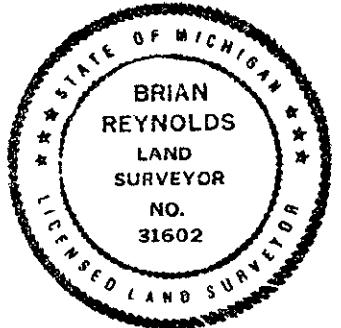

C. Description of monument for corner and accessories established to perpetuate locating the position of the corner:

- SET STANDARD BARRY COUNTY REMONUMENTATION MONUMENT (3/4"X36"W/ALUMINUM CAP)
SET 40d NAIL W/REMON TAG IN THE WEST SIDE OF A 12" MAPLE N6°E 21.92'
SET 40d NAIL W/REMON TAG IN THE NORTHEAST SIDE OF A 10" MAPLE N65°E 54.26'
SET 40d NAIL W/REMON TAG IN THE SOUTHERLY SIDE OF AN 8" MAPLE S60°E 54.86'
SET 40d NAIL W/REMON TAG IN THE EAST SIDE OF A 10" ASH S25°E 44.83'
SET 40d NAIL W/REMON TAG IN THE WEST SIDE OF A 14" MAPLE S10°W 45.04'
SOUTHEAST CORNER OF THE CONCRETE FOUNDATION OF A HOUSE N60°W 124.45'

Signed by [Signature] Date MARCH 17, 1995
Surveyor's Michigan License No. 31602