

SURVEY & REMONUMENTATION

AUG 22 1995

COMMISSION

BARRY COUNTY REMONUMENTATION

STATE OF MICHIGAN COUNTY OF BARRY RECEIVED FOR RECORD

MAR 20 10 55 AM '95

LAND CORNER RECORDATION CERTIFICATE Filing Requirement of Act 74, Mich. P.A. 1970

Sandy Schendelmarer REGISTER OF DEEDS

For corners in

BARRY (County)

Located In:

Corner Code #

Table with 2 columns: Description (1. Public Land Survey, 2. Property Controlling in Section, 3. Miscellaneous Property in Sec.) and T/R/S codes. Includes 'CENTER OF SECTION' and '2 CARLTON TOWNSHIP'. Corner code 'J-2' is noted.

002293

Register of Deeds Stamp & File Number

4. Lot No. , Recorded Plat
5. Private Claims

Grid table with columns A-M and rows 2-13. A black dot is present at the intersection of column J and row 2.

I, BRIAN REYNOLDS, in a field survey on 15 APRIL, 19 1994, do hereby certify that under requirements of P.A. 74, Michigan P.A. of 1970, the corner points mentioned in lines 1 and 2 above were in conformance with regulations and rules therefore as required in the current manual of survey instructions of the United States Department of the Interior, Bureau of Land Management or by a decree of a Court of Law and/or that the corner points mentioned in lines 3, 4 and 5 above were in conformance with the rules of the Michigan Board of Land Surveyors or by a Decree of a Court of Law; established, re-established, monumented, re-monumented, recovered, found as expressed below:

NOTE: Not more than 4 corners, all in the same town and range, may be recorded on this certificate.

A. Description of original monument and accessories and/or subsequent restoration:


- 1 CORNER NOT SET BY GENERAL LAND OFFICE
2 NO RECORDED HISTORICAL INFORMATION AVAILABLE FOR THIS CORNER

B. Description of corner evidence found and/or method applied in restoring or reestablishing corner:

SET STANDARD BARRY COUNTY REMONUMENTATION MONUMENT AT INTERSECTION OF 1/4 LINES

ACT 345 BARRY COUNTY REMONUMENTATION APPROVED BY PEER REVIEW AT A MEETING HELD ON

3 May '94 BRIAN REYNOLDS COUNTY SURVEYOR

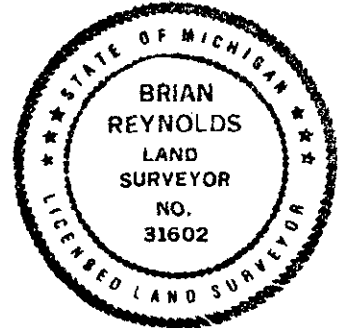

C. Description of monument for corner and accessories established to perpetuate locating the position of the corner:

- SET STANDARD BARRY COUNTY REMONUMENTATION MONUMENT (3/4"X36"W/ALUMINUM CAP)
SET 40d NAIL W/REMON TAG IN THE NORTH SIDE OF A 40" OAK N80°E 293.15'
SET 40d NAIL W/REMON TAG IN THE SOUTHWEST SIDE OF A 30" OAK S35°E 385.94'
K-2: N89°00'59"E 2623.82'
J-1: N01°29'39"W 2546.52'
J-3: S01°29'39"E 2642.92'
I-2: S89°00'59"W 2634.57'

Signed by [Signature] Surveyor's Michigan License No. 31602

Date MARCH 17, 1995