

SURVEY & REMONUMENTATION

AUG 22 1995

COMMISSION

BARRY COUNTY REMONUMENTATION

STATE OF MICHIGAN
COUNTY OF BARRY
RECEIVED FOR RECORD

LAND CORNER RECORDATION CERTIFICATE
Filing Requirement of Act 74, Mich. P.A. 1970

MAR 20 10 55 AM '95

Sandy Schendelmarer
REGISTER OF DEEDS

For corners in

BARRY
(County)

Located In:

Corner Code #

- 1. Public Land Survey T 4N R 8W K-2
- 1/4 CORNER COMMON TO T _____ R _____
- SECTIONS 1 & 2 T _____ R _____
- CARLTON TOWNSHIP T _____ R _____
- 2. Property Controlling S _____ T _____ R _____
- in Section S _____ T _____ R _____
- 3. Miscellaneous S _____ T _____ R _____
- Property in Sec. S _____ T _____ R _____

002296

Register of Deeds Stamp & File Number

- 4. Lot No. _____, Recorded Plat _____
- 5. Private Claims _____

	A	B	C	D	E	F	G	H	I	J	K	L	M
2	6	5	4	3	2	1							
3													
4	7	8	9	10	11	12							
5													
6	18	17	16	15	14	13							
7													
8	19	20	21	22	23	24							
9													
10	30	29	28	27	26	25							
11													
12	31	32	33	34	35	36							
13													

I, BRIAN REYNOLDS, in a field survey on 15 APRIL, 1994, do hereby certify that under requirements of P.A. 74, Michigan P.A. of 1970, the corner points mentioned in lines 1 and 2 above were in conformance with regulations and rules therefore as required in the current manual of survey instructions of the United States Department of the Interior, Bureau of Land Management or by a decree of a Court of Law and/or that the corner points mentioned in lines 3, 4 and 5 above were in conformance with the rules of the Michigan Board of Land Surveyors or by a Decree of a Court of Law; established, re-established, monumented, re-monumented, recovered, found as expressed below:

NOTE: Not more than 4 corners, all in the same town and range, may be recorded on this certificate.

A. Description of original monument and accessories and/or subsequent restoration:

**GENERAL LAND OFFICE: SYLVESTER SIBLEY, D.S., 1830(R8W,P.148),
SUGAR 14 N17E 23 Do. 16 S67W 30**

NO OTHER RECORDED HISTORICAL INFORMATION AVAILABLE FOR THIS CORNER.

B. Description of corner evidence found and/or method applied in restoring or reestablishing corner:

FOUND 1/2" IRON 2'+/- EAST OF CENTERLINE OF GRAVEL ROAD NORTH-SOUTH, IN LINE WITH VAGUE OCCUPATION EAST. EXCAVATED BELOW GRAVEL WITH BACKHOE: FOUND NOTHING. ACCEPTED 1/2" IRON AS BEST EVIDENCE OF CORNER POSITION. REPLACED 1/2" IRON WITH STANDARD BARRY COUNTY REMONUMENTATION MONUMENT.


ACT 345 BARRY COUNTY REMONUMENTATION
APPROVED BY PEER REVIEW AT A MEETING HELD ON

3 May 94
BRIAN REYNOLDS

BR
COUNTY SURVEYOR

C. Description of monument for corner and accessories established to perpetuate locating the position of the corner:

**SET STANDARD BARRY COUNTY REMONUMENTATION MONUMENT (3/4"X36"W/ALUMINUM CAP)
SET 40d NAIL W/PLASTIC TAG IN THE EAST SIDE OF A UTILITY POLE N10°E 97.48'
SET 40d NAIL W/PLASTIC TAG IN THE EAST SIDE OF A UTILITY POLE S5°E 209.62'
CORNER LIES 2'+/- EAST OF CENTERLINE OF A NORTH-SOUTH GRAVEL ROAD
K-3 LIES S00°54'17"E 2643.30'
K-1 LIES N01°00'09"W 2549.36'
J-2 LIES S89°38'29"W 2623.82'
NO OTHER ACCESSORIES LOCALLY AVAILABLE.**

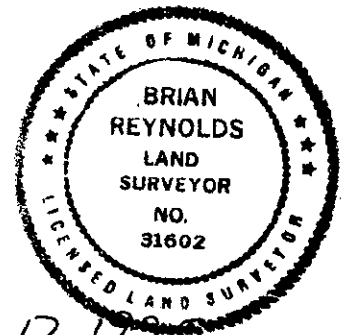

Signed by [Signature]

Date MARCH 17, 1995

Surveyor's Michigan License No. 31602