

FEB 03 1999

LAND CORNER RECORDATION CERTIFICATE
Filing Requirement of Act 74, Mich. P.A. 1970

For Corners in **SECTION**
BARRY
(county) Located In: Corner Code #



2703

Page: 1 of 1
11/25/1998 12:13P

1. Public Land Survey T 4N R 8W M-10
EAST 1/4 CORNER T _____ R _____
SECTION 25 T _____ R _____
CARLTON TOWNSHIP T _____ R _____
ON RANGE LINE
2. Property Controlling S _____ T _____ R _____
in Section S _____ T _____ R _____
3. Miscellaneous S _____ T _____ R _____

Sandy Schondelmayer - Barry Co. LCRCR

Register of Deeds Stamp & File Number

4. Lot No _____, Recorded Plat _____
5. Private Claims _____

I, Brian Reynolds, in a field survey on 9 OCT., 1997 do hereby certify that under requirements of P.A. 74, Michigan P.A. of 1970, the corner points mentioned in lines 1 and 2 above were in conformance with regulations and rules therefore as required in the current manual of survey instructions of the United States Department of the Interior, Bureau of Land Management or by a decree of a Court of Law and/or that the corner points mentioned in lines 3, 4, and 5 above were in conformance with the rules of the Michigan Board of Land Surveyors or by a Decree of a Court of Law; established, re-established, monumented, re-monumented, recovered, found as expressed below.

NOTE: Not more than 2 corners, all in the same town and range, may be recorded on this certificate.

| | A | B | C | D | E | F | G | H | I | J | K | L | M |
|----|----|----|----|----|----|----|---|---|---|---|---|---|---|
| 1 | | | | | | | | | | | | | |
| 2 | 6 | 5 | 4 | 3 | 2 | 1 | | | | | | | |
| 3 | | | | | | | | | | | | | |
| 4 | 7 | 8 | 9 | 10 | 11 | 12 | | | | | | | |
| 5 | | | | | | | | | | | | | |
| 6 | 18 | 17 | 16 | 15 | 14 | 13 | | | | | | | |
| 7 | | | | | | | | | | | | | |
| 8 | 19 | 20 | 21 | 22 | 23 | 24 | | | | | | | |
| 9 | | | | | | | | | | | | | |
| 10 | 30 | 29 | 28 | 27 | 26 | 25 | | | | | | | |
| 11 | | | | | | | | | | | | | |
| 12 | 31 | 32 | 33 | 34 | 35 | 36 | | | | | | | |
| 13 | | | | | | | | | | | | | |

A. Description of original monument and accessories and/or subsequent restoration:

- GENERAL LAND OFFICE: L. LYON, D.S., 1826, R7W, P.135) ELM 12 S5W 22 Do. 11 N87W 37
- NO MENTION OF THIS CORNER COULD BE FOUND IN THE COUNTY SURVEYOR RECORDS.
- LAND CORNER RECORDATION CERTIFICATE: #189, BY GEORGE YOUNG, P.S. #17640, 25 NOV. 1975 SET 1/2" RE-ROD WITH CAP ACCORDING TO GOVERNMENT REGULATIONS." NAIL IN 6" MAPLE N10°W 43.93' TOP ANGLE IRON FENCE POST S05°W 17.55' NAIL IN 6" ELM S45°E 72.98'

*** NO OTHER HISTORICAL INFORMATION, PUBLIC OR PRIVATE, AVAILABLE FOR THIS CORNER ***

B. Description of corner evidence found and/or method applied in restoring or reestablishing corner:


FOUND SLIGHT MAGNETIC EVIDENCE 8'+/- NORTH OF FENCE CORNER OCCUPATION WEST AT APPARENT CORNER LOCATION. EXCAVATION WITH BACKHOE REVEALED A VERTICAL RING OF SMALL-MEDIUM SIZED STONES, SIMILAR TO WHAT WE FIND AROUND A FENCE CORNER POST. VERTICAL RING OF STONES EXTENDED TO A DEPTH OF 3.5'+. ALSO FOUND VERY OLD FENCE WIRE 2-3 FEET BELOW GRADE SHAPED AS THOUGH IT WAS WRAPPED AROUND A FENCE POST AND RUNNING TO THE WEST. CENTER OF VERTICAL RING OF STONES LIES 4.18' EAST OF LINE FROM FOUND STONE AT M-11 TO REMONUMENTED M-9 & 0.70' SOUTH OF THE MIDPOINT. DISREGARDED POSITION AS RECORDED BY GEORGE YOUNG (ITEM #3 ABOVE). ACCEPTED CENTER OF VERTICAL RING OF STONES AS BEST AVAILABLE EVIDENCE OF CORNER POSITION. SET STANDARD BARRY COUNTY REMONUMENTATION MONUMENT IN CENTER OF VERTICAL RING OF STONES.

C. Description of monument for corner and accessories established to perpetuate locating the position of the corner:

SET STANDARD BARRY COUNTY REMONUMENTATION MONUMENT (3/4" X 36" IRON) WITH ALUMINUM CAP. TOP CENTER OF AN ANGLE IRON FENCE CORNER POST IN CONCRETE S75°W 32.05' SET 60d NAIL IN THE SOUTHEAST SIDE OF A 22" ELM S57°E 43.68' TOP CENTER OF A TELEPHONE RISER N72°E 26.51' FOUND 1/2" IRON (GEORGE YOUNG) N57°W 29.35' CORNER LIES 1'+/- WEST OF NORTH-SOUTH GRAVEL CENTERLINE 8'+/- NORTH OF FIELD SEAM RUNNING WEST A-10, T4N, R7W, WOODLAND TOWNSHIP, LIES NORTH 9.22'

ACT 345 BARRY COUNTY REMONUMENTATION
APPROVED BY PEER REVIEW AT A MEETING HELD ON

12 Oct. 98 BR
BRIAN REYNOLDS COUNTY SURVEYOR

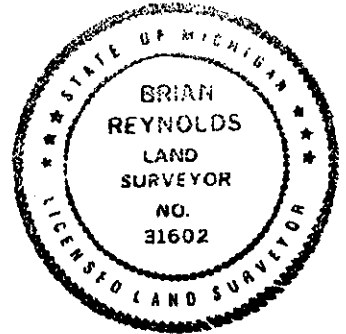

Signed by [Signature]
Surveyor's Michigan License No. 31602

Date Nov 24, 1998