

FEB 03 1999

LAND CORNER RECORDATION CERTIFICATE
Filing Requirement of Act 74, Mich. P.A. 1970

SECTION

For Corners in
BARRY
(county)

Located In: Corner Code #



2705

Page: 1 of 1
11/25/1998 12:13P

1. Public Land Survey
EAST 1/4 CORNER
SECTION 36
CARLTON TOWNSHIP
ON RANGE LINE

T 4N R 8W M-12
T _____ R _____
T _____ R _____
T _____ R _____

2. Property Controlling
in Section

S _____ T _____ R _____
S _____ T _____ R _____

3. Miscellaneous

S _____ T _____ R _____

Sandy Schonhelmayer - Barry Co. LCRCR

Register of Deeds Stamp & File Number

4. Lot No _____, Recorded Plat _____
5. Private Claims _____

I, Brian Reynolds, in a field survey on 23 NOV., 1998 do hereby certify that under requirements of P.A. 74, Michigan P.A. of 1970, the corner points mentioned in lines 1 and 2 above were in conformance with regulations and rules therefore as required in the current manual of survey instructions of the United States Department of the Interior, Bureau of Land Management or by a decree of a Court of Law and/or that the corner points mentioned in lines 3, 4, and 5 above were in conformance with the rules of the Michigan Board of Land Surveyors or by a Decree of a Court of Law; established, re-established, monumented, re-monumented, recovered, found as expressed below.


	A	B	C	D	E	F	G	H	I	J	K	L	M
1													
2	6	5	4	3	2	1							
3													
4	7	8	9	10	11	12							
5													
6	18	17	16	15	14	13							
7													
8	19	20	21	22	23	24							
9													
10	30	29	28	27	26	25							
11													
12	31	32	33	34	35	36							
13													

A. Description of original monument and accessories and/or subsequent restoration:
1. GENERAL LAND OFFICE: L. LYON, D.S., 1826 (R8W, P.135) BEECH 6 S23W 54 Do. N42W 28

*** NO OTHER HISTORICAL INFORMATION, PUBLIC OR PRIVATE, AVAILABLE FOR THIS CORNER ***

B. Description of corner evidence found and/or method applied in restoring or reestablishing corner:
FOUND NO MAGNETIC EVIDENCE OF CORNER POSITION. FOUND STONE AT M-11 AND FOUND A ROTTED WOOD STAKE IN A CIRCLE OF STONES AT A-11, WOODLAND TWP. EXCAVATION AT APPARENT CORNER POSITION REVEALED NOTHING.
SET STANDARD BARRY COUNTY REMONUMENTATION MONUMENT AT THE MID POINT AND ON LINE BETWEEN FOUND M-11 AND PREVIOUSLY REMONUMENTED M-13.

C. Description of monument for corner and accessories established to perpetuate locating the position of the corner:
SET STANDARD BARRY COUNTY REMONUMENTATION MONUMENT (3/4" X 36" IRON) WITH ALUMINUM CAP.
SET 20d NAIL W/PLASTIC TAG IN THE NORTH SIDE OF A 6" WOOD FENCE POST S86°W 27.80'
SET 20d NAIL W/PLASTIC TAG IN THE SOUTHWEST SIDE OF A 14" MAPLE S08°W 211.24'
SET 1/2" IRON W PLASTIC CAP (REYNOLDS TRAV. POINT) S13°E 50.13'
A-12, T4N, R7W, WOODLAND TOWNSHIP, LIES NORTH 5.94'
CORNER LIES ROUGHLY ON CENTERLINE OF NORTH-SOUTH GRAVEL ROAD
IN LINE WITH VAGUE OCCUPATION WEST

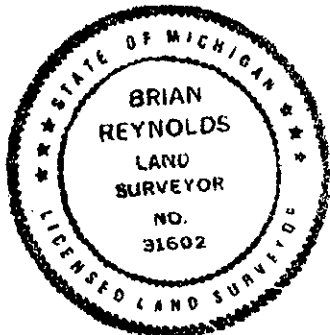

ACT 345 BARRY COUNTY REMONUMENTATION
APPROVED BY PEER REVIEW AT A MEETING HELD ON
12 OCT. 98 BR
BRIAN REYNOLDS COUNTY SURVEYOR

Signed by [Signature]
Surveyor's Michigan License No 31602

Date Nov 23, 1998
FORM APPROVED BY MICHIGAN STATE BOARD OF LAND SURVEYORS. JAN. 28, 1971
REVISED MAY 14, 1975 REVISED JANUARY, 1983 REVISED OCTOBER 1995