

LAND CORNER RECORDATION CERTIFICATE

FILING REQUIREMENT OF ACT 74, MICH. P.A.1970

Irving Township, Barry County, Michigan

FOR CORNERS OF--	LOCATED IN--	Sec. 19	CORNER CODE NUMBER
1. PUBLIC LAND SURVEY	T. 4	N. 2., R. 9	A-7 N.W. 19
2. PROPERTY CONTROLLING IN SECTION	T. _____	N. _____ S., R. _____ E. _____ W. _____	B-7 N 1/2
3. MISCELLANEOUS PROPERTY IN SECTION	T. _____	N. _____ S., R. _____ E. _____ W. _____	A-8 W 1/2 19
4. LOT NO. _____, RECORDED PLAT _____			
5. PRIVATE CLAIMS _____			

No. 385

FILED

MAR 21 88

SANDY SCHONDELMAYER
BARRY COUNTY REGISTER OF DEEDS

AT 9:18 A M

REGISTER OF DEEDS STAMP AND FILING NUMBER

I, Robert Jonker, do hereby certify that under requirements of P.A. 74, Michigan P.A. of 1970, the corner points mentioned in lines 1 and 2 above were, in a field survey on January 12, 1988, established, re-established, monumented, re-monumented, recovered or restored as expressed below and in conformance with regulations and rules therefore as required in the current manual of survey instructions of the United States Department of the Interior, Bureau of Land Management or by a decree of a court of law. Furthermore, that the corner points mentioned in lines 3, 4 and 5 above were, in a field survey on _____, 19____, found, recovered, restored, established or re-established as expressed below and in conformance with the rules of the Michigan State Board of Registration for Land Surveyors or, by a Decree of a Court of law:

A. Description of original monument and accessories and/or subsequent restoration:

A-7, Corner 39 links south of Thornapple Township corner
 B-7, No information
 A-8, No information

B. Description of corner evidence found and/or method applied in restoring or re-establishing corner:

A-7, Set on township line 39 links (25.74') feet south of Thornapple Township Corner
 B-7, Found 3/4" pipe on centerline East-West 2 track, on tree and fence line to south
 A-8, Found 1/2" rerod on centerline North-South gravel road


C. Description of monument for corner and accessories established to perpetuate locating the position of the corner:

<p>A-7 1/2" capped rerod (NW 1/4) P.K. nail - s. side p. pole N 70° E 98.67' Nail - S. side tw. 10" Oak S 85° W 54.93' Nail - S. side tw. 12" Oak N 50° W 68.23' 1/2" capped rerod N. 25.74' B-7 3/4" pipe Spk - w. side 24" Oak South 22.72' Spk - w. side 15" Oak N 10° E 21.8' Spk - s. side twin maple N 65° W 36.6'</p>	<p>A-8 1/2" rerod Spk - Ssw. side 36" maple S 65° E 27.85' Spk - nw. side 48" maple N 35° E 45.7' Spk. - ne. side 48" Oak N 60° W 43.8' 1/2" rerod, N. 17.1' (thornapple twp, corner) Fence to E, N 2 1/2' ± DATE 2-15-88</p>
--	--

SIGNED BY Robert J. Jonker
 Jonker Land Surveys
 SURVEYOR'S MICHIGAN REGISTRATION NO. 21572

FOR STATE AND UNITED STATES AGENCIES:

SIGNED BY _____ DATE _____
CHIEF OF SURVEY PARTY
 APPROVED AND SIGNED BY _____ DATE _____
MICHIGAN REGISTERED LAND SURVEYOR

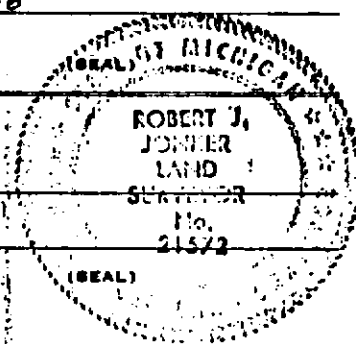

SURVEYOR'S MICHIGAN REGISTRATION NO. _____