

# LAND CORNER RECORDATION CERTIFICATE

FILING REQUIREMENT OF ACT 74, MICH. P.A. 1970

FOR CORNERS OF--	LOCATED IN--	CORNER CODE NUMBER
1. PUBLIC LAND SURVEY _____ T. _____	N. _____ S., R. _____ E. _____ W.	_____
2. PROPERTY CONTROLLING IN SECTION <u>16</u>	T. <u>4</u> N. <u>9</u> S., R. _____ E. _____ W.	<u>#7, #2</u>
3. MISCELLANEOUS PROPERTY IN SECTION _____	T. _____ N. _____ S., R. _____ E. _____ W.	_____
4. LOT NO. _____, RECORDED PLAT _____		
5. PRIVATE CLAIMS _____		

No. 362

## FILED

FEB 23 1984

**HOWARD J. FERRIS**  
Barry County Register of Deeds  
At 12:59 PM

REGISTER OF DEEDS STAMP AND FILING NUMBER

I, Donald Bissell, do hereby certify that under requirements of P.A. 74, Michigan P.A. of 1970, the corner points mentioned in lines 1 and 2 above were, in a field survey on September, 1983, established, re-established, monumented, re-monumented, recovered or restored as expressed below and in conformance with regulations and rules therefore as required in the current manual of survey instructions of the United States Department of the Interior, Bureau of Land Management or by a decree of a court of law. Furthermore, that the corner points mentioned in lines 3, 4 and 5 above were, in a field survey on \_\_\_\_\_, 19\_\_\_\_, found, recovered, restored, established or re-established as expressed below and in conformance with the rules of the Michigan State Board of Registration for Land Surveyors or, by a Decree of a Court of law:

A. Description of original monument and accessories and/or subsequent restoration:

B. Description of corner evidence found and/or method applied in restoring or re-establishing corner:

- |  |  |
|--|--|
| <p>#7 E 1/8 Corner, NE 1/4<br/>Set: 4"x36" Conc. Mon. with Alum. Cap Mid-way and on Line</p> | <p>#2 N 1/8 Corner, NE 1/4<br/>Set: 4"x36" Conc. Mon. with Alum. Cap Mid-way and on Line</p> |
|--|--|

C. Description of monument for corner and accessories established to perpetuate locating the position of the corner:

- |   |  |
|---|--|
| <p>#7 4"x36" Conc. Mon.<br/>S45°E - 24.33' - 5" Maple<br/>S22°E - 26.57' - 8" Basswood<br/>S75°W - 30.41' - 20" Oak<br/>N76°W - 26.28' - 8" Oak<br/>Corner is at the "T" intersection of the trails</p> | <p>#2 4"x36" Conc. Mon.<br/>N83°W - 11.91' - 10" Oak<br/>N08°E - 5.88' - 8" Basswood<br/>S55°E - 6.60' - 8" Oak<br/>S53°W - 11.90' - 12" W. Oak Fence Corner</p> |
|---|--|


SIGNED BY \_\_\_\_\_ DATE \_\_\_\_\_

SURVEYOR'S MICHIGAN REGISTRATION NO. \_\_\_\_\_

FOR STATE AND UNITED STATES AGENCIES:

SIGNED BY \_\_\_\_\_ DATE \_\_\_\_\_

APPROVED AND SIGNED BY Donald L. Bissell  
MICHIGAN REGISTERED LAND SURVEYOR

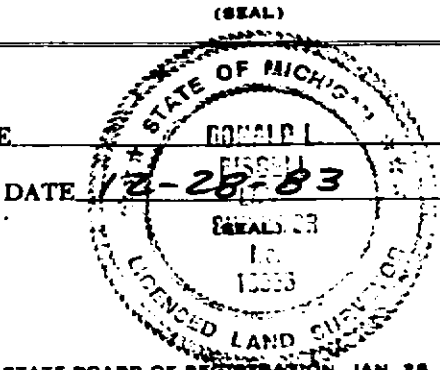

SURVEYOR'S MICHIGAN REGISTRATION NO. 18655