

LAND CORNER RECORDATION CERTIFICATE

FILING REQUIREMENT OF ACT 74, MICH. P.A.1970

FOR CORNERS OF--:	LOCATED IN--:	CORNER CODE NUMBER
1. PUBLIC LAND SURVEY _____	T. <u>4N</u> N. S., R. <u>9W</u> E. W.	<u>C-2, A-3, A-2</u>
2. PROPERTY CONTROLLING IN SECTION _____	T. _____ N. S., R. _____ E. W.	_____
3. MISCELLANEOUS PROPERTY IN SECTION _____	T. _____ N. S., R. _____ E. W.	_____
4. LOT NO. _____, RECORDED PLAT _____		
5. PRIVATE CLAIMS _____		

No. 254

FILED

DEC 29 1978

HOWARD J. FERRIS
Barry County Register of Deeds
At 10:55 P. M.

REGISTER OF DEEDS STAMP AND FILING NUMBER

I, Douglas W. Bonnema, do hereby certify that under requirements of P.A. 74, Michigan P.A. of 1970, the corner points mentioned in lines 1 and 2 above were, in a field survey on July 7, 1978, established, re-established, monumented, re-monumented, recovered or restored as expressed below and in conformance with regulations and rules therefore as required in the current manual of survey instructions of the United States Department of the Interior, Bureau of Land Management or by a decree of a court of law. Furthermore, that the corner points mentioned in lines 3, 4 and 5 above were, in a field survey on _____, 19____, found, recovered, restored, established or re-established as expressed below and in conformance with the rules of the Michigan State Board of Registration for Land Surveyors or, by a Decree of a Court of law:

A. Description of original monument and accessories and/or subsequent restoration:

B. Description of corner evidence found and/or method applied in restoring or re-establishing corner:

C-2 - Set corner on ϕ gravel to N and S and on line with tree and brush lines to E and W.	A-3 Set corner 55.44' S of SE corner of Section 1, T4N, R10W, per G.L.O. notes.	A-2 Set corner by pro-rating the mile distance in the ratio of dimensions given in G.L.O. notes. For line, held E 1/4 corner and SE corner of Sec. 1, T4N, R10W.
--	---	--

C. Description of monument for corner and accessories established to perpetuate locating the position of the corner:

C-2 Capped re-rod. <u>E 1/4 Cor 6</u> Nail in sde 10" Walnut WSW 41.08' Nail in sde 26" Walnut SSW 92.39' Nail in sde 4" Cedar NE 62.71'	A-3 1/2" iron pipe. <u>NW Cor 7</u> Nail in sde 18" Walnut ESE 72.98' PK in sde P. Pole SW 56.33' PK in sde T. Pole W 88.64' PK in sde T. Pole NNW 63.16' ϕ E-W B.T. pav't N 20'+ 3/4" iron (SE cor Sec. <u>T-4-10</u>) North 55.44'	A-2 Capped re-rod <u>W 1/4 Cor 6</u> Iron @ E 1/4 Cor Sec. 1-4-10 North 47.92' Nail in sde Db1. 14" Maple NNW 40.63' Nail in sde 16" Maple SW 21.71' Nail in sde 18" Maple SE 24.52' Nail in sde 8" W. Cherry ENE 15.95' fence line to East N 3'±
---	--	---


SIGNED BY Douglas W Bonnema DATE December 26, 1978
 EXCEL ENGINEERING, INC.

SURVEYOR'S MICHIGAN REGISTRATION NO. 12579

FOR STATE AND UNITED STATES AGENCIES:

SIGNED BY _____ DATE _____
CHIEF OF SURVEY PARTY

APPROVED AND SIGNED BY _____ DATE _____
MICHIGAN REGISTERED LAND SURVEYOR

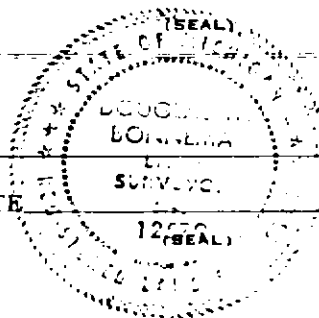

SURVEYOR'S MICHIGAN REGISTRATION NO. _____