

MAY 20 1997

STATE OF MICHIGAN
COUNTY OF BARRY
RECORDS DEPARTMENT

BARRY COUNTY REMONUMENTATION
LAND CORNER RECORDATION CERTIFICATE
Filing Requirement of Act 74, Mich. P.A. 1970

DEC 10 11 57 AM '96

Sandy S. Swickman
REGISTER OF DEEDS

For corners in

Barry County
(County)

Located In: Irving Twp. Corner Code # A-1

1. Public Land Survey T 4N R 9W NW Cor. Sec. 6
T ___ R ___
SAME AS T 4N R 10W 7-1
T ___ R ___
2. Property Controlling S ___ T ___ R ___
in Section S ___ T ___ R ___
3. Miscellaneous S ___ T ___ R ___
Property in Sec. S ___ T ___ R ___
4. Lot No. _____, Recorded Plat _____
5. Private Claims _____

002455
Register of Deeds Stamp & File Number

T4N R9W T4N R10W

	A	B	C	D	E	F	G	H	I	J	K	L	M
2	6	5	4	3	2	1							
3													
4	7	8	9	10	11	12							
5													
6	18	17	16	15	14	13							
7													
8	19	20	21	22	23	24							
9													
10	30	29	28	27	26	25							
11													
12	31	32	33	34	35	36							
13													

I, Robert Jonker, in a field survey on November 29, 19 96, do hereby certify that under requirements of P.A. 74, Michigan P.A. of 1970, the corner points mentioned in lines 1 and 2 above were in conformance with regulations and rules therefore as required in the current manual of survey instructions of the United States Department of the Interior, Bureau of Land Management or by a decree of a Court of Law and/or that the corner points mentioned in lines 3, 4 and 5 above were in conformance with the rules of the Michigan Board of Land Surveyors or by a Decree of a Court of Law; established, re-established, monumented, re-monumented, recovered, found as expressed below:

NOTE: Not more than 4 corners, all in the same town and range, may be recorded on this certificate.

A. Description of original monument and accessories and/or subsequent restoration:

K.C. LCRC #1131, 1978, MVK
Spike in W side 28" Oak S-SE 131.55'
Spike in SW side 26" Mulberry NW 33.46'
PK in SE side P & T Pole NE 36.88'

-see over-

B. Description of corner evidence found and/or method applied in restoring or reestablishing corner:

Took witnesses in Spring of 1996 prior to road construction, reset position Fall of 1996 from construction witness and survey of parcel to the South in Barry Co.

Set Std. K.C. Mon. (Harrison)


Accepted as the best available evidence of the position of the corner.

ACT 345 BARRY COUNTY REMONUMENTATION
APPROVED BY PEER REVIEW AT A MEETING HELD ON

12-6-96 BR
BRIAN REYNOLDS COUNTY SURVEYOR

C. Description of monument for corner and accessories established to perpetuate locating the position of the corner:

Kent Co. Mon. (Harrison)
Kent Co. Remon nail & tag on NW side P.Pole S60°W 56.52'
Kent Co. Remon nail & tag on N side G.Pole N33°W 39.10'
Kent Co. Remon nail & tag in SE side P.Pole N44°E 36.90'
C/L base of street sign post S63°E 48.3'
Top of NW cor. steel guard rail post S19°W 63.24'
@ C/L "X"

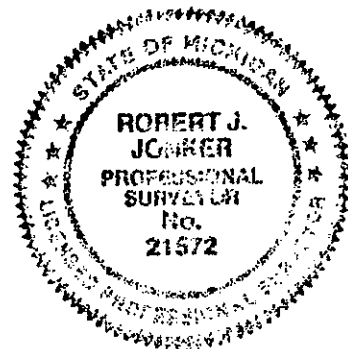

Signed by Robert J. Jonker
Surveyor's Michigan License No. 21572

Date December 2, 1996

2455-A

Part A Con't.

K.C. LCRC #1715, 1981, W&W, K.C. Mon.

Nail & remon tag in SW side 24" Mulberry	N40°W 33.39'
Nail & remon tag in W side 31" Oak	S10°E 131.54'
Nail & remon tag in SE side 18" Pear	S55°W 118.98'
Nail & remon tag in S side 6" Maple	N60°W 58.56'
Nail & remon tag in E side 27" Mulberry	N10°W 87.55'
Nail & remon tag in W side 8" Cedar	N40°E 40.75'
Nail & remon tag in N side 12" Maple	S80°E 126.13'

Set Mon. 3" under surface of gravel road N-S & E-W

K.C. LCRC #7002, 1994, Wm. Byl

Nail & remon tag SW side 32" Mulberry	N40°W 33.39'
Nail & remon tag W side 31" Oak stump	S10°E 131.57'
Nail & remon tag S side 12" Maple	N60°W 58.5'
Nail & remon tag E side 30" Mulberry	N10°W 87.55'
Nail & remon tag W side 12" Cedar	N40°E 40.75'
Nail & remon tag N side 18" Maple	S80°E 126.13'

SURVEY &
REMONUMENTATION

MAY 20 1997

COMMISSION