

# SURVEY & REMONUMENTATION

FEB 17 1998

## Barry County Remonumentation LAND CORNER RECORDATION CERTIFICATE Filing Requirement of Act 74, Mich. P.A. 1970

For corner in **SECTION**

Barry Co.  
(County)

Located In:  
Irving Twp.

Corner Code #



**2674**

Page: 1 of 1  
01/14/1998 01:05P

Sandy Schondelmayer - Barry Co. LCRCR

1. Public Land Survey	T <u>4</u> N R <u>9</u> W	<u>C-9</u>
	T ___ R ___	_____
	T ___ R ___	_____
	T ___ R ___	_____
2. Property Controlling in Section	S ___ T ___ R ___	_____
	S ___ T ___ R ___	_____
3. Miscellaneous Property in Sec.	S ___ T ___ R ___	_____
	S ___ T ___ R ___	_____

Register of Deeds Stamp & File Number

4. Lot No. \_\_\_\_\_, Recorded Plat \_\_\_\_\_  
5. Private Claims \_\_\_\_\_

I, Robert Jonker, in a field survey on 05-10, 1996 do hereby state that under requirements of P.A. 74, Michigan P.A. of 1970, the corner points mentioned in lines 1 and 2 above were in conformance with regulations and rules therefore as required in the current manual of survey instructions of the United States Department of the Interior, Bureau of Land Management or by a decree of a Court of Law and/or that the corner points mentioned in lines 3, 4 and 5 above were in conformance with the rules of the Michigan Board of Land Surveyors or by a Decree of a Court of Law; established, re-established, monumented, recovered, found as expressed below:

NOTE: Not more than 2 corners, all in the same town and range, may be recorded on this certificate.

	A	B	C	D	E	F	G	H	I	J	K	L	M
1													
2	6		5		4		3		2		1		
3													
4	7		8		9		10		11		12		
5													
6	19		17		16		15		14		13		
7													
8	19		20		21		22		23		24		
9													
10	30		29		28		27		26		25		
11													
12	31		32		33		34		35		36		
13													

A. Description of original monument and accessories and/or subsequent restoration:

1830, S. Sibley, D.S., GLO survey	County Road Com. No date	1997
80.00 set post in prairie,	2" iron sleighshoe	checked OK
corner to sec. 19, 20, 29, 30	8" Elm N 70° E 36.9'	out
A W.Oak 12 N 46° E 2.0	14" Elm N 45° W 21.4'	out
Do 7 S 47½° E 129	20" Popl. N 10° E 104.4'	checked OK

B. Description of corner evidence found and/or method applied in restoring or reestablishing corner:


Found 2" iron sleigh shoe by wit. noted in "A" above.

ACT 345 BARRY COUNTY REMONUMENTATION  
APPROVED BY PEER REVIEW AT A MEETING HELD ON  
12 Jan '98  
BRIAN REYNOLDS COUNTY SURVEYOR

Accepted as a careful and faithful perpetuation of the position of the original corner.

C. Description of monument for corner and accessories established to perpetuate locating the position of the corner:

Set standard Barry Co. Monument over sleighshoe.	
Found PK Nail W. side 10" Elm	N 18° E 43.55'
Found 60 "D" Spk. NNW side Tri-Elm	S 50° W 33.15'
Found PK Nail W. side fence post	S 5° W 25.54'
Set 60 "D" Spk. W. 48" Poplar	N 13° E 104.51'
Set Remon. tag SW side 12" Stump	S 52° E 60.16'
Set Remon. tag NE side 14" tree	N 56° W 27.39'

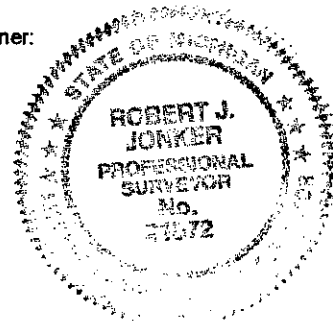

Signed by Robert J. Jonker  
Surveyor's Michigan License No. 21572

Date 12-31-97