

SURVEY & REMONUMENTATION

FEB 17 1998

**Barry County Remonumentation
LAND CORNER RECORDATION CERTIFICATE
Filing Requirement of Act 74, Mich. P.A. 1970**

SECTION

For corners in

Barry Co. (County)

Located In: Irving Twp.

Corner Code #



2667
Page: 1 of 1
01/02/1998 07:49A

Sandy Schondelmayer - Barry Co. LCRCR

- 1. Public Land Survey T 4 N R 9 W D-11
- T R
- T R
- T R
- 2. Property Controlling S T R
- in Section S T R
- 3. Miscellaneous S T R
- Property in Sec. S T R

Register of Deeds Stamp & File Number

4. Lot No. _____, Recorded Plat _____
5. Private Claims _____

Robert Jonker, in a field survey on 05-10, 1997 do hereby state that under requirements of P.A. 74, Michigan P.A. of 1970, the corner points mentioned in lines 1 and 2 above were in conformance with regulations and rules therefore as required in the current manual of survey instructions of the United States Department of the Interior, Bureau of Land Management or by a decree of a Court of Law and /or that the corner points mentioned in lines 3, 4 and 5 above were in conformance with the rules of the Michigan Board of Land Surveyors or by a Decree of a Court of Law; established, re-established, monumented, recovered, found as expressed below:

NOTE: Not more than 2 corners, all in the same town and range, may be recorded on this certificate.

A	B	C	D	E	F	G	H	I	J	K	L	M
1												
2	6		5		4		3		2		1	
3												
4	7		8		9		10		11		12	
5												
6	18		17		16		15		14		13	
7												
8	19		20		21		22		23		24	
9												
10	30		29		28		27		26		25	
11												
12	31		32		33		34		35		36	
13												

A. Description of original monument and accessories and/or subsequent restoration:

B.L.O. survey - 1830, S. Sibley, D.S.
West corrected between 29 & 32
39.90 set post on true line
A W. Oak 7 N 27 E 21
D.O. 16 S 23 1/2 W 49 1/2

LCRC #367 - MVK -1982
Part A - Nothing
Part B - Fd. nail on C/L of a E-W gravel road & on fence & tree row to South, 6' W. of Nagel Road
Reset with capped iron 1997
Part C - Took witnesses

Sq. spk. W. side 12" Hickory SSE 23.55' (M=23.62')
Sq. spk. NW side 18" Hickory SSW 28.52' (M=28.52')

B. Description of corner evidence found and/or method applied in restoring or reestablishing corner:

NE'ly faces 5' dia. steel manhole SW 40.0' OK
C/L st. sign post NE 40.23' out


Found MVK capped rerod by witnesses listed in "A" above (1982). ACT 345 BARRY COUNTY REMONUMENTATION APPROVED BY PEER REVIEW AT A MEETING HELD ON

8 April '96
BRIAN REYNOLDS COUNTY SURVEYOR

Accepted as a careful and faithful perpetuation of the position of the original corner.

C. Description of monument for corner and accessories established to perpetuate locating the position of the corner:

Replaced with standard Barry County monument.
Barry Co. Remon. tag NE side 10" Elm N 50° W 58.88'
Barry Co. Remon. tag SE side 24" Elm N 73° E 79.70'
Barry Co. Remon. tag W. side 15" Hickory S 14° E 23.59'
Barry Co. Remon. tag NW side 18" Hickory S 47° W 28.57'
Nearest face of manhole S 70° W 40.00'
on C/L E-W & N & fence to South

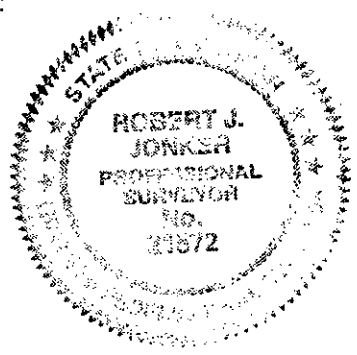

Signed by Robert J. Jonker
Surveyor's Michigan License No. 21572

Date December 30, 1997