

SURVEY & REMONUMENTATION

Barry County Remonumentation

FEB 03 1999

LAND CORNER RECORDATION CERTIFICATE
Filing Requirement of Act 74, Mich. P.A. 1970

SECTION

For corners in

Barry
(County)

Located In:

Corner Code #

1. Public Land Survey

4N 9W
T___ R___
T___ R___
T___ R___
T___ R___
S___ T___ R___
S___ T___ R___
S___ T___ R___
S___ T___ R___

E-1 (NW corner Sec.4)

~~Irving Twp.~~

Sandy Schondelmayer - Barry Co. LCRCR



2717

Page: 1 of 2
12/15/1998 08:24A

Register of Deeds Stamp & File Number

4. Lot No. _____, Recorded Plat _____
5. Private Claims _____

I, Steven Koerber, in a field survey on May 29, 1998 do hereby state that under requirements of P.A. 74, Michigan P.A. of 1970, the corner points mentioned in lines 1 and 2 above were in conformance with regulations and rules therefore as required in the current manual of survey instructions of the United States Department of the Interior, Bureau of Land Management or by a decree of a Court of Law and for that the corner points mentioned in lines 3, 4 and 5 above were in conformance with the rules of the Michigan Board of Land Surveyors or by a Decree of a Court of Law; established, re-established, monumented, recovered, found as expressed below:

NOTE: Not more than 2 corners, all in the same town and range, may be recorded on this certificate.

	A	B	C	D	E	F	G	H	I	J	K	L	M
1													
2	6			5		4			3			2	1
3													
4	7			8		9			10			11	12
5													
6	18			17		16			15			14	13
7													
8	19			20		21			22			23	24
9													
10	30			29		28			27			26	25
11													
12	31			32		33			34			35	36
13													

A. Description of original monument and accessories and/or subsequent restoration:

E-1 GLO- Set Post- Sibley, 1830
81.65 North boundary 17 lks East of post.
An Elm 7 S60°W 14
A. B. Ash 16 S56°E 48
(Additional info. on back)


B. Description of corner evidence found and/or method applied in restoring or reestablishing corner:

E-1 Found 1/2" rerod
Nail in N'y side 12" Maple ENE 54.82'
SE corner Sec. 32-5-9 Bowne Twp. Kent Co. West 11.31'

ACT 345 BARRY COUNTY REMONUMENTATION
APPROVED BY PEER REVIEW AT A MEETING HELD ON
Dec 8, 1997 BR
BRIAN REYNOLDS COUNTY SURVEYOR

C. Description of monument for corner and accessories established to perpetuate locating the position of the corner:

E-1 Replaced 1/2" rerod with Barry Co. Mon. (3/4" x 24" Iron Rod with cap)
Nail with K.C. remon tag in N. side 18" tri-Maple N65°E 54.83'
Set nail & washer in N. side 18" Maple S70°W 48.60'
Set nail & washer in N. side 12" twin Maple N80°E 62.44'
Set nail & washer in SW side 28" Maple S75°E 110.55'
SE corner Sec. 32-5-9 Bowne Twp., Kent Co. West 11.31'
C/1 'x' roads to N-S-E 9± South 2±West

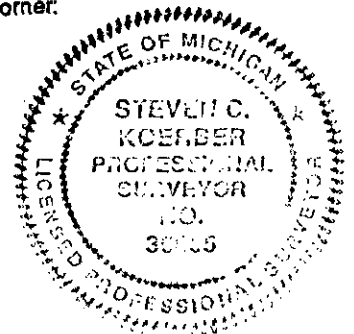

Surveyor's Michigan License No. 39085

Date 10-12-1998



Sandy Schondelmayer - Barry Co. LCRCR

2. L.C.R.C. #313 Doug Bonnema (May 1981)

Set capped iron. Set by holding gov't distance of 11.22' East of SE corner, Sec. 32-5-9.

Nail in NE side 12" Ash	SE	64.51'
Nail in N'ly side 12" Maple	ENE	54.82'
Nail in W'ly side 10" Hickory	SSE	73.93'
Nail in S. side 18" Oak East		53.03'
Nail in W'ly side 28" Twin Oak	NNE	26.48'

SURVEY &
REMONUMENTATION

FEB 03 1999

SECTION