

FEB 03 1999

Barry County Remonumentation

SECTION

LAND CORNER RECORDATION CERTIFICATE  
Filing Requirement of Act 74, Mich. P.A. 1970

For corners in

Barry Located In: Corner Code #  
(County)

1. Public Land Survey 4N 9W E-2 (W 1/4 corner Sec.4)  
T\_\_\_ R\_\_\_ Irving Twp.  
T\_\_\_ R\_\_\_  
T\_\_\_ R\_\_\_  
T\_\_\_ R\_\_\_

2. Property Controlling S\_\_\_ T\_\_\_ R\_\_\_  
in Section S\_\_\_ T\_\_\_ R\_\_\_

3. Miscellaneous S\_\_\_ T\_\_\_ R\_\_\_  
Property in Sec. S\_\_\_ T\_\_\_ R\_\_\_



2718  
Page: 1 of 2  
12/15/1998 08:24R

Sandy Schondelmayer - Barry Co. LCRCR

Register of Deeds Stamp & File Number

4. Lot No. \_\_\_\_\_, Recorded Plat \_\_\_\_\_  
5. Private Claims \_\_\_\_\_

I, Steven Koerber, in a field survey on May 29, 1998 do hereby state that under requirements of P.A. 74, Michigan P.A. of 1970, the corner points mentioned in lines 1 and 2 above were in conformance with regulations and rules therefore as required in the current manual of survey instructions of the United States Department of the Interior, Bureau of Land Management or by a decree of a Court of Law and/or that the corner points mentioned in lines 3, 4 and 5 above were in conformance with the rules of the Michigan Board of Land Surveyors or by a Decree of a Court of Law, established, re-established, monumented, recovered, found as expressed below:

NOTE: Not more than 2 corners, all in the same town and range, may be recorded on this certificate.

	A	B	C	D	E	F	G	H	I	J	K	L	M
1													
2	6			5	●	4		3		2		1	
3													
4	7			8		9		10		11		12	
5													
6	18			17		16		15		14		13	
7													
8	19			20		21		22		23		24	
9													
10	30			29		28		27		26		25	
11													
12	31			32		33		34		35		36	
13													

A. Description of original monument and accessories and/or subsequent restoration:

E-2	GLO- Set Post, A.W. Oak 16 S33°W 37 Do 6 N61°E 10  (Additional info. on back)	1. April 21, 1880 A.C. Willson Set a stake Large & small stone original post lost	2. May 22, 1979 L.C.R.C. #271 by Harold Oliver (L.C.R.C. #271 found to be in error)
-----	---	--	---


B. Description of corner evidence found and/or method applied in restoring or reestablishing corner:

E-2 Found 1/2" capped rerod  
Nail in N'y side 12" Walnut SW 29.10  
Nail in SW side 16" Walnut SE 39.92'  
Nail in W'y side 28" Twin Oak NNE 26.48'

ACT 345 BARRY COUNTY REMONUMENTATION  
APPROVED BY PEER REVIEW AT A MEETING HELD ON  
DEC 8, 1997 BR  
BRIAN REYNOLDS COUNTY SURVEYOR

C. Description of monument for corner and accessories established to perpetuate locating the position of the corner:

E-2 Replaced 1/2" rerod with Barry Co. Mon. ( 3/4" x 24" Iron Rod with cap)  
Set nail & washer in E. side twin 24" Oak N30°E 26.68'  
Set nail & washer in N. side 12" Oak S70°E 13.66'  
Set nail & washer in N. side 18" Walnut S55°W 28.91'  
Set nail & washer in N. side 18" Hickory N65°W 27.84'  
Set nail & washer in SW side 18" Hickory S30°E 40.11'  
C/ 2 track road 2± West

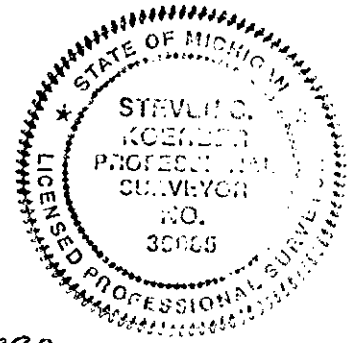

Signed by Steven C. Koerber  
Surveyor's Michigan License No. 39085

Date 10-12-1998

FEB 08 1999

SECTION

E-2 Page 2 of 2



2718

Page: 2 of 2  
12/15/1998 08:24A

Sandy Schondelmayer - Barry Co. LCRCR

3.. Act 132 recorded survey  
May 1979 Harold Oliver  
same wits as No. 1 above

4.. L.C.R.C. #313 Doug Bonnema (May 1981)

Set capped iron on line with Section corners to N-S and by prorating the Gov't distance for the mile.

Nail in NE side 20" Walnut	N30°W	47.73'
Nail in N'ly side 12" Walnut	SW	29.10'
Nail in SW side 16" Walnut	SE	39.92'
Nail in N. side 14" Oak East		53.03'
Nail in W'ly side 28" Twin Oak	NNE	26.48'