

SURVEY & REMONUMENTATION

FEB 03 1999

Barry County Remonumentation

SECTION

LAND CORNER RECORDATION CERTIFICATE
Filing Requirement of Act 74, Mich. P.A. 1970

For corners in

<u>Barry</u> (County)	Located In:	Corner Code #
	4N 9W	E-3 (SW corner Sec.4)
1. Public Land Survey	T___ R___	Irving Twp.
	T___ R___	_____
	T___ R___	_____
2. Property Controlling in Section	S___ T___ R___	_____
	S___ T___ R___	_____
3. Miscellaneous Property in Sec.	S___ T___ R___	_____
	S___ T___ R___	_____



2716

Page: 1 of 2
12/15/1998 08:24A

Sandy Schondelmayer - Barry Co. LCRCR

Register of Deeds Stamp & File Number

4. Lot No. _____, Recorded Plat _____
5. Private Claims _____

I, Steven Koerber, in a field survey on July 17, 1998 do hereby state that under requirements of P.A. 74, Michigan P.A. of 1970, the corner points mentioned in lines 1 and 2 above were in conformance with regulations and rules therefore as required in the current manual of survey instructions of the United States Department of the Interior, Bureau of Land Management or by a decree of a Court of Law and /or that the corner points mentioned in lines 3, 4 and 5 above were in conformance with the rules of the Michigan Board of Land Surveyors or by a Decree of a Court of Law; established, re-established, monumented, recovered, found as expressed below:

NOTE: Not more than 2 corners, all in the same town and range, may be recorded on this certificate.

A	B	C	D	E	F	G	H	I	J	K	L	M
1												
2	6		5		4		3		2		1	
3				●								
4	7		8		9		10		11		12	
5												
6	18		17		16		15		14		13	
7												
8	19		20		21		22		23		24	
9												
10	30		29		28		27		26		25	
11												
12	31		32		33		34		35		36	
13												

A. Description of original monument and accessories and/or subsequent restoration:

E-3	GLO- Set Post- Sibley, 1830	2. 1880
	A. Beech 5 N48°E 13	A.C. Willson
	Do 7 S34°W 20	Found by U.S. field notes, old bearing to be seen & set stone and crockery
	(Additional info. on back)	


B. Description of corner evidence found and/or method applied in restoring or reestablishing corner:

E-3 Found 3/8" iron pipe in Mon. box
3/8" pipe was adjacent to stone surrounded by brick and crockery
PK nail in N. side RR tie fnc. post N89°E 25.49'
Nail in NE side 16" Hickory N32°W 62.68'
Nail in root W. side 30" Oak S46°E 33.25' (not Doug Bonnema's wit)

ACT 345 BARRY COUNTY REMONUMENTATION
APPROVED BY PEER REVIEW AT A MEETING HELD ON
OCT 12, 1998 BR
BRIAN REYNOLDS COUNTY SURVEYOR

C. Description of monument for corner and accessories established to perpetuate locating the position of the corner:

E-3 Replaced stone with Barry Co. Mon. (3/4" x 24" Iron Rod with cap)
Set nail & washer in NW side 18" Oak N38°E 53.40'
PK nail in N. side RR tie fnc. post N89°E 25.49'
Nail in NE side 16" Hickory N32°W 62.68'
Nail in root W. side 30" Oak S46°E 33.25' (not Doug Bonnema's wit)
C/I N-S road 1' West
C/I road to West 5'± South
In line with fence to East

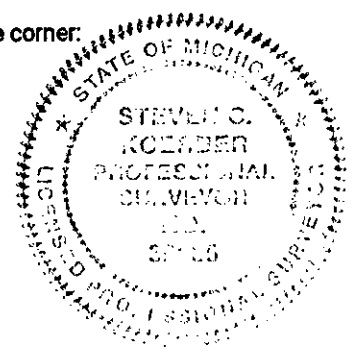

Signed by [Signature]
Surveyor's Michigan License No. 39085

Date 10-12-1998



3. County Road Comm. notes

Stone

Corner fence post	East	26.0'
20" Elm	SE	53.8'
10" Hickory	N45W	51.0'

SURVEY &
REMONUMENTATION

FEB 03 1999

SECTION

4. Act 132 survey 8-30-1973 Roy DeHaven Liber 1, Pg. 115
Iron & Mon. Box

10" Hickory	N45°W	48.8'
Twin Cedar	N60°E	35.0'
Corner fence post	East	25.2'

5. Act 132 survey 9-25-1973 Roy DeHaven Liber 1, Pg. 132
same wits as No. 4 above

6. Act 132 survey 6-30-1979 Harold Oliver Liber 1, Pg. 517-520
same wits as No. 4 above

7. L.C.R.C. #313 Doug Bonnema (May 1981)
Found 3/4" iron in Mon. box. Checks with certificate #272 by Harold Oliver.

Nail in SW side	22" Oak	SE	34.51'
Nail in NW side	14" Oak	NE	53.66'
Nail in NE side	14" Hickory	N30°W	62.69'
PK Nail in N. side	corner fence post	East	25.47'
Nail in SW side	10" Hickory	N50°W	52.57'

8. Act 132 survey 6-10-1981 Doug Bonnema Liber 1, Pg. 658-660
3/8" iron in Mon. Box
wits same as No. 7 above

9. Act 132 survey 10-2-1989 Rodney Unema Liber 1, Pg. 948
3/8" pipe in Mon. box

Nail in SW side	22" Oak	SE	34.51'
PK Nail in NE. side	corner fence post	S80°E	26.47'
Nail in NE side	12" Hickory	N30°W	82.67'

10. Act 132 survey 2-10-1992 Charles Fricke Liber 2, Pg. 61-62
wits same as No. 9 above

11. Act 132 survey 12-8-1992 Charles Fricke Liber 2, Pg. 69-72
wits same as No. 9 above

12. Act 132 survey 2-10-197 Charles Fricke Liber 2, Pg. 151
wits same as No. 9 above