

APR 08 1996

COMMISSION

BARRY COUNTY REMONUMENTATION

LAND CORNER RECORDATION CERTIFICATE

Filing Requirement of Act 74, Mich. P.A. 1970

STATE OF MICHIGAN COUNTY OF BARRY RECEIVED FOR RECORD

DEC 15 3 07 PM '95

Sandy Schondelmarer

REGISTER OF DEEDS

002367

Register of Deeds Stamp & File Number

For corners in

BARRY

(County)

Located In:

Corner Code #

1. Public Land Survey	T	4N	R9W	E-4
1/4 CORNER COMMON TO SECTIONS 8 & 9 IRVING TOWNSHIP	T		R	
	T		R	
	T		R	
2. Property Controlling in Section	S		T	R
	S		T	R
3. Miscellaneous Property in Sec.	S		T	R
	S		T	R

- 4. Lot No. _____, Recorded Plat _____
- 5. Private Claims _____

BRIAN REYNOLDS in a field survey on 8 OCT. 19 95

do hereby certify that under requirements of P.A. 74, Michigan P.A. of 1970, the corner points mentioned in lines 1 and 2 above were in conformance with regulations and rules therefore as required in the current manual of survey instructions of the United States Department of the Interior, Bureau of Land Management or by a decree of a Court of Law and/or that the corner points mentioned in lines 3, 4 and 5 above were in conformance with the rules of the Michigan Board of Land Surveyors or by a Decree of a Court of Law; established, re-established, monumented, re-monumented, recovered, found as expressed below:

NOTE: Not more than 4 corners, all in the same town and range, may be recorded on this certificate.

A. Description of original monument and accessories and/or subsequent restoration:

- GENERAL LAND OFFICE: SYLVESTER SIBLEY, D.S., 1830 (R9W,P.176) A LYNN 13 N59E 24 A BEECH 16 S52W 53
- COUNTY SURVEYOR RECORDS: A.C. WILLSON, 1880 (L.1,P.294) "FOUND POST BY BRICK IN THE GROUND AND TOOK NEW BEARING" A CHERRY 12 S36W 48
- COUNTY ROAD COMMISSION: "STONE" FE. POST SE 36.8' 18" ELM NE 41.9' 18" HICKORY NW 38.8'
- ACT 132 SURVEY: BY R.F. DEHAVEN P.S.#3380(L.1,P.115) "STONE" FENCE POST S.E. 36.8' 18" HICKORY N.E. 39.4' 12" OAK S20°W 60.4' 14" HICKORY N75°W 95.5'
- ACT 132 SURVEY: BY R.F. DEHAVEN P.S.#3380(L.1,P.132) RECITE SAME WITNESSES AS IN L.1,P.115 ABOVE
- ACT 132 SURVEY: BY R.D.UNEMA, P.S.#33987(L.1,P.948) "LARGE SPIKE" NAIL NE SDE 22" HICKORY N40°W 39.87' NAIL SE SDE 20" OAK S30°W 60.86' PK. SDE T. POLE N45°E 75.17'
- ACT 132 SURVEY: BY C.E.FRICKE, P.S.#21781(L.2,P.61-62) RECITE SAME WITNESSES AS IN L.1,P.948 ABOVE

B. Description of corner evidence found and/or method applied in restoring or reestablishing corner:

FOUND A LARGE "PK" NAIL ROUGHLY AT THE INTERSECTION OF CENTERLINES OF NORTH-SOUTH BITUMINOUS ROAD AND GRAVEL ROAD EAST (ABANDONED WEST). BASED ON WITNESSES FROM ROAD COMMISSION AND SURVEY BY DEHAVEN BELIEVE "PK" TO BE POSITION OF STONE. CORNER LIES IN A FILL AREA. EXCAVATION REVEALED NOTHING. ACCEPTED FOUND "PK" AS THE PERPETUATION OF CORNER POSITION.

REPLACED "PK" WITH STANDARD BARRY COUNTY REMONUMENTATION MONUMENT.

ACT 345 BARRY COUNTY REMONUMENTATION APPROVED BY PEER REVIEW AT A MEETING HELD ON

12/11/95


BRIAN REYNOLDS

BR

COUNTY SURVEYOR

C. Description of monument for corner and accessories established to perpetuate locating the position of the corner:

- SET STANDARD BARRY COUNTY REMONUMENTATION MONUMENT (3/4"X36"W/ALUMINUM CAP)
- SET 20d NAIL W/REMON TAG IN THE EAST SIDE OF A 24" OAK S22°W 61.00'
- SET 20d NAIL W/REMON TAG IN THE EAST SIDE OF AN 18" HICKORY S16°W 85.74'
- SET 20d NAIL W/REMON TAG IN THE EAST SIDE OF A 20" HICKORY N41°W 39.94'
- SET 20d NAIL W/REMON TAG IN THE WEST SIDE OF A 16" ELM N18°E 83.11'
- SET 20d NAIL W/REMON TAG IN THE WEST SIDE OF AN 8" HICKORY N39°E 56.69'
- CENTERLINE OF A NORTH-SOUTH BITUMINOUS ROAD (SOLOMAN) LIES 0.7' EAST ROUGHLY ON CENTERLINE OF A GRAVEL ROAD EAST (LOFTUS)

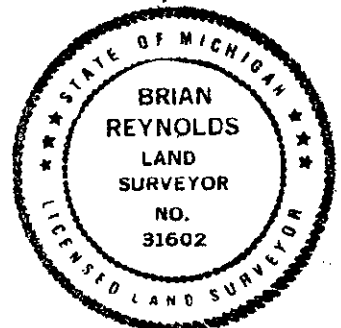

Signed by

Date

12/15/95

Surveyor's Michigan License No.

31602

