SURVEY & REMONUMENTATION

OCT 25 1993

COMMISSION

STATE OF MICHIGAN
COUNTY OF BARRY
RECEIVED FOR RECORD

AUG 18 8 00 AM '93

Sandy Schondelmayer
REGISTER OF DEEDS

LAND CORNER RECORDATION CERTIFICATE

Filing Requirement of Act 74, Mich: P.A. 1970

For corners in Barry (County)

	Located In:	Corner Code ##
1. Public Land Survey	T 4N R 9W	E7
	T ___ R ___	IRVING TWP.
	T ___ R ___	
	T ___ R ___	
2. Property Controlling	S ___ T ___ R ___	
in Section	S ___ T ___ R ___	
3. Miscellaneous	S ___ T ___ R ___	
Property in Sec.	S ___ T ___ R ___	

002074

Register of Deeds Stamp & File Number

4. Lot No. _____ , Recorded Plat _____
5. Private Claims _____

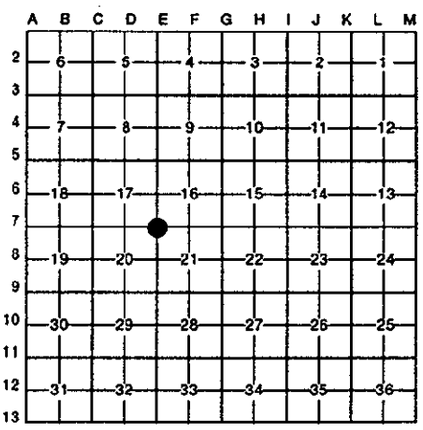

I, Gary C. Bilow, in a field survey on February 11, 1993, 19 _____, do hereby certify that under requirements of P.A. 74, Michigan P.A. of 1970, the corner points mentioned in lines 1 and 2 above were in conformance with regulations and rules therefore as required in the current manual of survey instructions of the United States Department of the Interior, Bureau of Land Management or by a decree of a Court of Law and/or that the corner points mentioned in lines 3, 4 and 5 above were in conformance with the rules of the Michigan Board of Land Surveyors or by a Decree of a Court of Law; established, re-established, monumented, re-monumented, recovered, found as expressed below:

NOTE: Not more than 4 corners, all in the same town and range, may be recorded on this certificate.

A. Description of original monument and accessories and/or subsequent restoration:
E7:Post established by U. S. Deputy Surveyor S. Sibley in 1830 - accessories: Maple 14 N57E 23 links and Tamarack 8 S60W 25 links. County Surveyor Frank Bowen records in Volume 1 page 271 in 1878 "Found post and old bearings - took new ones: Maple 14 S33W 35 and Elm 5 S33-1/2 E 53."

B. Description of corner evidence found and/or method applied in restoring or reestablishing corner:
E7: Found stone by projecting line between Northeast and North 1/4 corner at 1878 County Surveyor distance from the North 1/4 corner. Accepted this stone as the best evidence of the original GLO post.

C. Description of monument for corner and accessories established to perpetuate locating the position of the corner:
E7: Replaced Stone with 1/2" x 24" rebar with plastic cap stamped "G.C. Bilow LLS 26453"
N15E 15.69'. Nail & Tag in 12" Maple
S9E 43.00'. Nail & Tag in 8" Aspen
S70W 6.71'. Nail & Tag in 20" Maple
N41W 29.69'. Nail & Tag in 13" Maple

STATE OF MICHIGAN
GARY C. BILOW
PROFESSIONAL SURVEYOR
No. 26453
LICENSED PROFESSIONAL SURVEYOR

Signed by Gary C. Bilow Date 5/6/93

Surveyor's Michigan License No. 26453

FORM APPROVED BY MICHIGAN STATE BOARD OF LAND SURVEYORS, JAN. 28, 1971
REVISED MAY 14, 1975
REVISED JAN., 1983

10/26/93