

FEB 17 1998

SECTION

Barry County Remonumentation  
LAND CORNER RECORDATION CERTIFICATE  
Filing Requirement of Act 74, Mich. P.A. 1970

For corners in

Barry Co.  
(County)

Located In:  
Irving Twp.

Corner Code #



2668

Page: 1 of 1  
01/02/1998 07:49A

Sandy Schondelmayer - Barry Co. LCRCR

1. Public Land Survey

T 4 N R 9 W  
T     R      
T     R      
T     R      
T     R    

E-10

2. Property Controlling in Section

S     T     R      
S     T     R      
S     T     R      
S     T     R    

3. Miscellaneous Property in Sec.

4. Lot No. \_\_\_\_\_, Recorded Plat \_\_\_\_\_

5. Private Claims \_\_\_\_\_

Register of Deeds Stamp & File Number

I, Robert Jonker, in a field survey on 3-29, 19 95 do hereby state that under requirements of P.A. 74, Michigan P.A. of 1970, the corner points mentioned in lines 1 and 2 above were in conformance with regulations and rules therefore as required in the current manual of survey instructions of the United States Department of the Interior, Bureau of Land Management or by a decree of a Court of Law and/or that the corner points mentioned in lines 3, 4 and 5 above were in conformance with the rules of the Michigan Board of Land Surveyors or by a Decree of a Court of Law; established, re-established, monumented, recovered, found as expressed below:

NOTE: Not more than 2 corners, all in the same town and range, may be recorded on this certificate.

	A	B	C	D	E	F	G	H	I	J	K	L	M
1													
2	6		5		4		3		2		1		
3													
4	7		8		9		10		11		12		
5													
6	18		17		16		15		14		13		
7													
8	19		20		21		22		23		24		
9													
10	30		29		28		27		26		25		
11													
12	31		32		33		34		35		36		
13													

A. Description of original monument and accessories and/or subsequent restoration:

G.L.O. survey - 1830 S. Sibley D.S.  
North between Sec. 28 & 29  
40.00 set post  
A X. Oak 20 N 86 E 51  
A W. Oak 10 N 69 1/2 W 55

Lee Cobb, Co. Surveyor, 1908  
Stone in place L. 1, P. 363

ACT 345 BARRY COUNTY REMONUMENTATION  
APPROVED BY PEER REVIEW AT A MEETING HELD ON  
8 April '96  
BRIAN REYNOLDS COUNTY SURVEYOR


B. Description of corner evidence found and/or method applied in restoring or reestablishing corner:

Corner is in a cut area - dug trench - did not find stone  
Set corner on C/L N-S road and on fence line to East

Accepted as the best available evidence of the position of the original corner.

C. Description of monument for corner and accessories established to perpetuate locating the position of the corner:

Set standard Barry County monument.  
Set Pk Nail N. side p. pole N 55° W 47.43'  
Set Spk N. side 36" Oak S 85° E 38.43'  
Set Spk W. side 20" Oak N 35° E 67.95'  
Set Spk N. side 16" Oak S 45° W 42.93'  
on C/L N-S gravel road  
on line fence and tree row to East

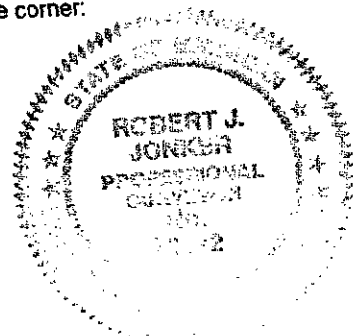

Signed by Robert J. Jonker  
Surveyor's Michigan License No. 21572

Date December 01, 1997