

FEB 03 1999

SECTION

Barry County Remonumentation

LAND CORNER RECORDATION CERTIFICATE
Filing Requirement of Act 74, Mich. P.A. 1970

For corners in

Barry	Located in:	Corner Code #
(County)		
1. Public Land Survey	T4N R 9W	F-2 (Central 1/4 corner Sec 4)
	T R	Irving Twp.
	T R	
	T R	
2. Property Controlling in Section	S T R	
	S T R	
3. Miscellaneous Property in Sec.	S T R	
	S T R	



2713
Page: 1 of 1
12/15/1998 09:24A
Sandy Schondelmayer - Barry Co. LCRCR

Register of Deeds Stamp & File Number

4. Lot No. _____, Recorded Plat _____
5. Private Claims _____

I, Steven Koerher, in a field survey on July 17, 1998 do hereby state that under requirements of P.A. 74, Michigan P.A. of 1970, the corner points mentioned in lines 1 and 2 above were in conformance with regulations and rules therefore as required in the current manual of survey instructions of the United States Department of the Interior, Bureau of Land Management or by a decree of a Court of Law and/or that the corner points mentioned in lines 3, 4 and 5 above were in conformance with the rules of the Michigan Board of Land Surveyors or by a Decree of a Court of Law; established, re-established, monumented, recovered, found as expressed below:

NOTE: Not more than 2 corners, all in the same town and range, may be recorded on this certificate.

	A	B	C	D	E	F	G	H	I	J	K	L	M
1													
2	6			5					3			2	1
3													
4	7			8					10			11	12
5													
6	18			17					15			14	13
7													
8	19			20					22			23	24
9													
10	30			29					27			26	25
11													
12	31			32					34			35	36
13													

A. Description of original monument and accessories and/or subsequent restoration:

F-2 Corner not set by GLO surveyors

1. Act 132 survey 9-6-1988
Paul Van Kooten
Capped Iron
12" Oak NE 37.68'
36" Oak SE 43.30'


ACT 345 BARRY COUNTY REMONUMENTATION
APPROVED BY PEER REVIEW AT A MEETING HELD ON
JAN 12, 1998
BRIAN REYNOLDS COUNTY SURVEYOR

B. Description of corner evidence found and/or method applied in restoring or reestablishing corner:

F-2 Found 1/2" rerod with cap
Disregarded capped rerod, due to wrong East 1/4 corner monument held to establish this position.
Held intersection of 1/4 lines for monument position of Central 1/4 corner, using the found old iron and crockery for the East 1/4 corner monument as documented by the Barry Co. Road Comm. notes.

C. Description of monument for corner and accessories established to perpetuate locating the position of the corner:

F-2 Set Barry Co. Mon. (3/4" x 24" Iron Rod with cap)
Set nail & washer in NW side 24" Oak N60°E 66.01'
Set nail & washer in E side 18" Walnut N20°E 35.17'
Set nail & washer in W side 20" Hackberry S15°E 25.18'
Set nail & washer in S side 24" Walnut S80°W 89.52'
Fenceline to South East 5'
Centerline Road North 9'
Capped rerod North 13.28'

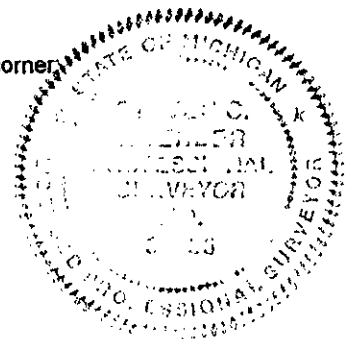

Signed by Brian Reynolds Date 10-12-1998
Surveyor's Michigan License No. 39085