

APR 08 1996

COMMISSION

BARRY COUNTY REMONUMENTATION

LAND CORNER RECORDATION CERTIFICATE
Filing Requirement of Act 74, Mich. P.A. 1970

STATE OF MICHIGAN
COUNTY OF BARRY
RECEIVED FOR RECORD

DEC 15 3 07 PM '95

Sandy Schondelmar
REGISTER OF DEEDS

002370

Register of Deeds Stamp & File Number

For corners in

BARRY

(County)

Located In:

Corner Code #

1. Public Land Survey	T	<u>4N</u>	R	<u>9W</u>	<u>F-3</u>
CORNER COMMON TO	T		R		
SECTIONS 4 & 9	T		R		
IRVING TOWNSHIP	T		R		
2. Property Controlling	S		T	R	
In Section	S		T	R	
3. Miscellaneous	S		T	R	
Property in Sec.	S		T	R	

4. Lot No. _____, Recorded Plat _____
5. Private Claims _____

I, BRIAN REYNOLDS, in a field survey on 8 OCT., 19 95

do hereby certify that under requirements of P.A. 74, Michigan P.A. of 1970, the corner points mentioned in lines 1 and 2 above were in conformance with regulations and rules therefore as required in the current manual of survey instructions of the United States Department of the Interior, Bureau of Land Management or by a decree of a Court of Law and/or that the corner points mentioned in lines 3, 4 and 5 above were in conformance with the rules of the Michigan Board of Land Surveyors or by a Decree of a Court of Law; established, re-established, monumented, re-monumented, recovered, found as expressed below:


NOTE: Not more than 4 corners, all in the same town and range, may be recorded on this certificate.

A. Description of original monument and accessories and/or subsequent restoration:

GENERAL LAND OFFICE: SYLVESTER SIBLEY, D.S., 1830 (R9W,P.177) "WEST CORRECTED 39.97"
A. B. OAK 22 S46W 32 A. BEECH 7 N41E 15
COUNTY SURVEYOR RECORDS: A.C. WILLSON MAR. 16, 1880 (L.1,P.295) "SET AT EQUAL DISTANCE (39.73)"
A SASSAFRASS 5 S31W 28 1/2 WHITE OAK 14 N47E 47
NO OTHER RECORDED HISTORICAL INFORMATION AVAILABLE FOR THIS CORNER.
PRIVATE NOTES OF SURVEY BY PAUL VAN KOOTEN P.S.#8618 "FOUND STONE IN RING OF STONES.
REPLACED WITH 1 1/2" SOLID IRON"

B. Description of corner evidence found and/or method applied in restoring or reestablishing corner:


FOUND 1 1/2" SOLID IRON BY VAN KOOTEN. BASED ON TRAVERSE OF ALL OF SECTION 9, ACCEPTED 1 1/2" SOLID IRON AS THE PERPETUATION OF THE CORNER POSITION.
REPLACED 1 1/2" IRON WITH STANDARD BARRY COUNTY REMONUMENTATION MONUMENT.

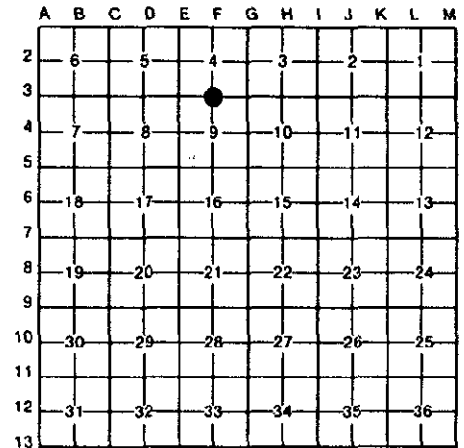

ACT 345 BARRY COUNTY REMONUMENTATION
APPROVED BY PEER REVIEW AT A MEETING HELD ON
12/11/95 BR
BRIAN REYNOLDS **COUNTY SURVEYOR**

C. Description of monument for corner and accessories established to perpetuate locating the position of the corner:

SET STANDARD BARRY COUNTY REMONUMENTATION MONUMENT (3/4"X36"W/ALUMINUM CAP)
SET 20d NAIL W/REMON TAG IN THE EAST SIDE OF A 30" OAK N12°W 18.42'
SET 20d NAIL W/REMON TAG IN THE SOUTHEAST SIDE OF A 12" MAPLE N20°E 25.89'
SET 20d NAIL W/REMON TAG IN THE SOUTH SIDE OF A 12" OAK N88°E 8.58'
SET 20d NAIL W/REMON TAG IN THE SOUTH SIDE OF A 12" OAK N83°W 28.43'
SET 20d NAIL W/REMON TAG IN THE SOUTH SIDE OF AN 8" OAK N50°W 19.08'
CENTERLINE OF AN EAST-WEST TRAIL ROAD (PARMALEE) LIES 20'+/- SOUTH
CORNER IS 6'+/- EAST OF AN OLD TREE/FENCE LINE RUNNING NORTH
3'+/- SOUTH OF AN EAST-WEST FENCE

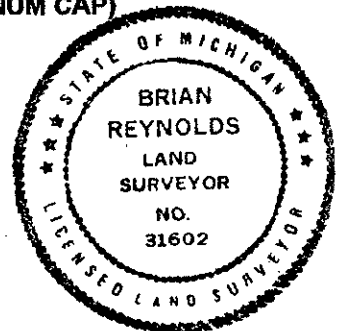

Signed by [Signature]

Date 12/15/95

Surveyor's Michigan License No. 31602