

APR 08 1996

COMMISSION

BARRY COUNTY REMONUMENTATION

LAND CORNER RECORDATION CERTIFICATE
Filing Requirement of Act 74, Mich. P.A. 1970

STATE OF MICHIGAN
COUNTY OF BARRY
RECEIVED FOR RECORD

DEC 15 3 07 PM '95

Sandy Schondelmarer

REGISTER OF DEEDS

002369

Register of Deeds Stamp & File Number

For corners in

BARRY

(County)

Located In:

Corner Code #

1. Public Land Survey	T	<u>4N</u>	<u>R9W</u>	<u>F-4</u>
CENTER OF SECTION	T	_____	R _____	_____
9 IRVING TOWNSHIP	T	_____	R _____	_____
	T	_____	R _____	_____
2. Property Controlling	S	_____	T _____	R _____
in Section	S	_____	T _____	R _____
3. Miscellaneous	S	_____	T _____	R _____
Property in Sec.	S	_____	T _____	R _____


4. Lot No. _____, Recorded Plat _____
 5. Private Claims _____

I, BRIAN REYNOLDS, in a field survey on 6 OCT., 1995, do hereby certify that under requirements of P.A. 74, Michigan P.A. of 1970, the corner points mentioned in lines 1 and 2 above were in conformance with regulations and rules therefore as required in the current manual of survey instructions of the United States Department of the Interior, Bureau of Land Management or by a decree of a Court of Law and/or that the corner points mentioned in lines 3, 4 and 5 above were in conformance with the rules of the Michigan Board of Land Surveyors or by a Decree of a Court of Law; established, re-established, monumented, re-monumented, recovered, found as expressed below:

NOTE: Not more than 4 corners, all in the same town and range, may be recorded on this certificate.

A. Description of original monument and accessories and/or subsequent restoration:

CORNER NOT SET BY THE GENERAL LAND OFFICE.
COUNTY SURVEYOR RECORDS: A.C. WILLSON, 16 MARCH, 1880 (L.1,P.295)
A. HICKORY 8 S74°W 56 SUGAR 4 S72 1/4°E 114
NO OTHER RECORDED HISTORICAL INFORMATION AVAILABLE FOR THIS CORNER.

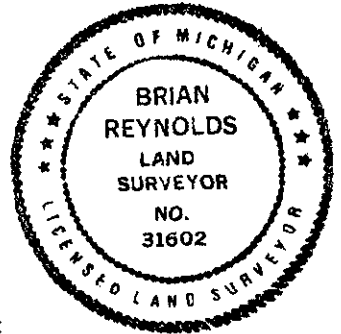

B. Description of corner evidence found and/or method applied in restoring or reestablishing corner:

FOUND 3/4" PINCH PIPE NEAR CENTER OF SECTION. BASED ON TRAVERSE OF ALL OF SECTION 9 AND PART OF SECTION 16, FOUND PINCH PIPE TO BE 27.40' SOUTH AND 6.65' WEST OF THE INTERSECTION OF 1/4 LINES. INTERSECTION OF 1/4 LINES FALLS IN AN AREA THAT HAS BEEN DEEPLY CUT (12'-15') BY ROAD CONSTRUCTION. FOUND REMAINS OF A 40"+ STUMP S70°30'W 37.24' POSSIBLY WILLSON'S HICKORY WITNESS. DISREGARDED PINCH PIPE AND SET MONUMENT AT THE INTERSECTION OF 1/4 LINES.

SET STANDARD BARRY COUNTY REMONUMENTATION MONUMENT, WITH ALUMINUM CAP.

ACT 345 BARRY COUNTY REMONUMENTATION
 APPROVED BY PEER REVIEW AT A MEETING HELD ON
12/11/95
 BRIAN REYNOLDS
 COUNTY SURVEYOR

C. Description of monument for corner and accessories established to perpetuate locating the position of the corner:

SET STANDARD BARRY COUNTY REMONUMENTATION MONUMENT (3/4"X36"W/ALUMINUM CAP)
SET 20d NAIL W/PLASTIC TAG IN THE NORTH SIDE OF A 15" MAPLE S79°W 25.97'
SET 20d NAIL W/PLASTIC TAG IN THE SOUTH SIDE OF A 30" OAK N72°W 56.70'
SET 20d NAIL W/PLASTIC TAG IN THE SOUTH SIDE OF AN 8" MAPLE CLUSTER N80°W 114.36'
SET 20d NAIL W/PLASTIC TAG IN THE EAST ROOT OF A 12" POPLAR S16°W 4.76'
SET 20d NAIL W/PLASTIC TAG IN THE SOUTH SIDE OF A 6" MAPLE N78°E 59.55'
CORNER LIES 4.5' +/- SOUTH OF THE TRAVELED CENTERLINE OF AN EAST-WEST GRAVEL ROAD (LOFTUS ROAD) AND IS INSIDE OF A VERY DEEPLY CUT AREA (12'-15')
FOUND PINCH PIPE S13°24'W 28.19'

Signed by

Date

12/15/95

Surveyor's Michigan License No.

31602