

APR 08 1996

COMMISSION

For corners in

BARRY
(County)

BARRY COUNTY REMONUMENTATION

LAND CORNER RECORDATION CERTIFICATE
Filing Requirement of Act 74, Mich. P.A. 1970

STATE OF MICHIGAN
COUNTY OF BARRY
RECEIVED FOR RECORD

DEC 15 3 07 PM '95

Sandy Schindelmarjer
REGISTER OF DEEDS


1. Public Land Survey
1/4 CORNER COMMON TO
SECTIONS 9 & 16
IRVING TOWNSHIP

Located In:	Corner Code --#
T <u>4N</u> <u>R9W</u>	<u>F-5</u>
T _____ R _____	_____
T _____ R _____	_____
T _____ R _____	_____
S _____ T _____ R _____	_____
S _____ T _____ R _____	_____
S _____ T _____ R _____	_____
S _____ T _____ R _____	_____

002368

Register of Deeds Stamp & File Number

4. Lot No. _____, Recorded Plat _____
5. Private Claims _____

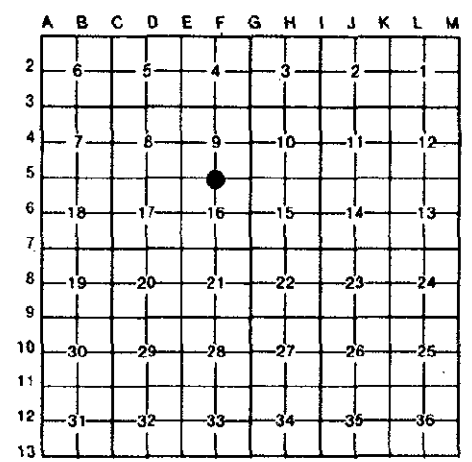

I, BRIAN REYNOLDS, in a field survey on 6 OCT. 1995

do hereby certify that under requirements of P.A. 74, Michigan P.A. of 1970, the corner points mentioned in lines 1 and 2 above were in conformance with regulations and rules therefore as required in the current manual of survey instructions of the United States Department of the Interior, Bureau of Land Management or by a decree of a Court of Law and/or that the corner points mentioned in lines 3, 4 and 5 above were in conformance with the rules of the Michigan Board of Land Surveyors or by a Decree of a Court of Law; established, re-established, monumented, re-monumented, recovered, found as expressed below:

NOTE: Not more than 4 corners, all in the same town and range, may be recorded on this certificate.

A. Description of original monument and accessories and/or subsequent restoration:

GENERAL LAND OFFICE: SYLVESTER SIBLEY, D.S., 1830 (R9W,P.176) W. OAK 32 S16W 30 IRONWOOD 6 N2 1/2E 48 COUNTY SURVEYOR: A.C. WILLSON, MARCH 16, 1880(L.1,P.294) "SOUTH 1/4 POST OFF SET 25 LKS NORTH OLD BEARINGS. TOOK NEW BEARINGS" BEECH 10 S39 1/2W 40 CHERRY 10 N18W 8 1/2 ALSO: LEE COBB, NOV. 25-28, 1890(BOOK IX,P.114) "IDENTIFIED BY OLD STAKE ONE U.S. TREE & TWO BEARINGS BY WILLSON 1880"
LAND CORNER RECORDATION CERTIFICATE: #360 BY D.L. BISSELL, P.S.#18655, FEB 23, 1984, "SET 4"X36" CONC. MON. AT FENCE INTERSECTION AND 2,640' FROM WEST AS CALLED FOR IN PREVIOUS SURVEY"
N22°W-9.90'-18" MAPLE N62°E-11.00'-24" MAPLE S10°W-31.27'-7" SASSAFRASS N88°W-19.23'-5" MAPLE ACT 132 SURVEY: BY D.L. BISSELL, (L.1,P.760) 10-83, RECITES SAME WITNESSES AS IN L.C.R.C. # 360 ABOVE

B. Description of corner evidence found and/or method applied in restoring or reestablishing corner:

FOUND AN OLD 3/4" PIPE AT INTERSECTION OF FENCES, S74°21'W, 4.57' FROM BISSELL'S MONUMENT. BASED ON TRAVERSE OF ALL OF SECTION 9 AND PART OF SECTION 16, ALONG WITH OCCUPATION LINES, ACCEPTED FOUND PIPE AS BETTER EVIDENCE OF CORNER POSITION THAN PREVIOUSLY RECORDED. DISREGARDED MONUMENT BY BISSELL. REPLACED FOUND PIPE WITH STANDARD BARRY COUNTY REMONUMENTATION MONUMENT.

ACT 345 BARRY COUNTY REMONUMENTATION
APPROVED BY PEER REVIEW AT A MEETING HELD ON

12/11/95 BR
BRIAN REYNOLDS COUNTY SURVEYOR

C. Description of monument for corner and accessories established to perpetuate locating the position of the corner:

SET STANDARD BARRY COUNTY REMONUMENTATION MONUMENT (3/4"X36" W/ALUMINUM CAP)
SET 20d NAIL W/PLASTIC TAG IN THE NORTHEAST SIDE OF A 10" CHERRY S20°W 37.42'
SET 20d NAIL W/PLASTIC TAG IN THE NORTHEAST SIDE OF A 10" HICKORY S33°E 32.75'
FOUND NAIL W/D.N.R. TAG IN THE NORTHWEST SIDE OF A 30" MAPLE N64°E 15.42'
FOUND NAIL W/D.N.R. TAG IN THE WEST SIDE OF A 20" MAPLE N1°E 9.83'
FOUND NAIL W/D.N.R. TAG IN THE NORTH SIDE OF AN 8" MAPLE N87°W 14.85'
FOUND NAIL W/D.N.R. TAG IN THE WEST SIDE OF A 12" SASSAFRASS DUE SOUTH 29.61'
CORNER IS IN LINE WITH FENCES NORTH AND WEST.
7'+/- NORTH OF NORTH EDGE OF TRAIL ROAD.



Signed by [Signature]

Date 12/15/95

Surveyor's Michigan License No. 31602