

FEB 03 1999

Barry County Remonumentation

SECTION

LAND CORNER RECORDATION CERTIFICATE  
Filing Requirement of Act 74, Mich. P.A. 1970

For corners in

Barry Located In: Corner Code #  
(County)

1. Public Land Survey T4N R 9W G-1 (NE corner Sec.4)  
T R Irving Twp.  
T R  
T R  
T R

2. Property Controlling S T R  
in Section S T R

3. Miscellaneous S T R  
Property in Sec. S T R



2719  
Page: 1 of 2  
12/15/1998 08:24A

Sandy Schondelmayer - Barry Co. LCRCR

Register of Deeds Stamp & File Number

4. Lot No. \_\_\_\_\_, Recorded Plat \_\_\_\_\_  
5. Private Claims \_\_\_\_\_

I, Steven Koerber, in a field survey on May 29 98, 19\_\_\_\_ do hereby state that under requirements of P.A. 74, Michigan P.A. of 1970, the corner points mentioned in lines 1 and 2 above were in conformance with regulations and rules therefore as required in the current manual of survey instructions of the United States Department of the Interior, Bureau of Land Management or by a decree of a Court of Law and /or that the corner points mentioned in lines 3, 4 and 5 above were in conformance with the rules of the Michigan Board of Land Surveyors or by a Decree of a Court of Law; established, re-established, monumented, recovered, found as expressed below:

NOTE: Not more than 2 corners, all in the same town and range, may be recorded on this certificate.

	A	B	C	D	E	F	G	H	I	J	K	L	M
1													
2	6	5						3	2				1
3													
4	7	8	9	10	11	12							
5													
6	18	17	16	15	14	13							
7													
8	19	20	21	22	23	24							
9													
10	30	29	28	27	26	25							
11													
12	31	32	33	34	35	36							
13													

A. Description of original monument and accessories and/or subsequent restoration:

G-1	GLO- Set Post- Sibley, 1830 81.96 North boundary 27 lks West of post. A Sugar 7 S61°E 46 An Aspin 12 S71°W 40	1. A.C. Willson April 1880 Lynn 14 S21W 29 Sugar 12 S48 1/2E 95	2. Lee Cobb 1908 Found sugar tree by Willson & stone & stake
-----	--	--	---

(Additional info. on back)

B. Description of corner evidence found and/or method applied in restoring or reestablishing corner:

G-1 Found 1/2" rerod  
0.73' South of Township Line  
Nail in N'y side 12" Maple ENE 54.82'  
SE corner Sec. 33-5-9 Bowne Twp. Kent Co. East 17.82'

ACT 345 BARRY COUNTY REMONUMENTATION  
APPROVED BY PEER REVIEW AT A MEETING HELD ON  
Dec 8, 1997 BR  
BRIAN REYNOLDS COUNTY SURVEYOR


Set Barry County Monument on Township line and 17.82 feet West of SE corner Sec. 33-5-9 Bowne Township Kent County

C. Description of monument for corner and accessories established to perpetuate locating the position of the corner:

G-1 Set Barry Co. Mon. ( 3/4" x 24" Iron Rod with cap)  
Nail with K.C. remon tag in SE side 18" Oak N50°E 41.20'  
Nail with K.C. remon tag in S side tri-12" Oak S85°W 15.16'  
Set nail & washer in SW side 12" Basswood S35°E 12.95'  
Kent County Monument (SE corner Sec. 33-5-9 Bowne Twp., Kent Co.) East 17.82'  
C/l road North 9'  
Rerod South 0.73'  
Capped rerod N30°E 37.46'

Signed by [Signature]  
Surveyor's Michigan License No. 39085

Date 10-12-1998

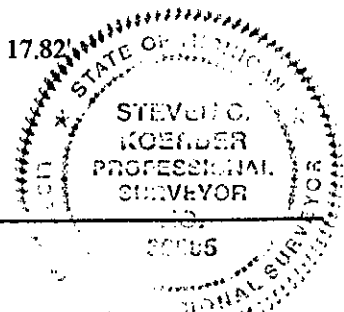



2719

Page: 2 of 2  
12/15/1998 08:24A

Sandy Schondelmayer - Barry Co. LCRCR

G-1 Irving Twp. Page 2 of 2

3. L.C.R.C. #105 James King Nov-7-1973  
reset by proportional methods  
Set 1/2" rerod  
10" Oak N30°E 40.73'  
8" Oak clump S80°W 15.07'  
South edge of gravel road

4. Kent County L.C.R.C. #5381 Thomas Starr(April 1990)  
Southeast corner Sec.33, Bowne Twp. Kent Co.  
References 1/2" rerod West 17.80 feet (Northeast corner Sec. 4, Irving Twp. Barry Co.)

SURVEY &  
REMONUMENTATION

FEB 03 1999

SECTION