

FEB 03 1999

Barry County Remonumentation

SECTION

LAND CORNER RECORDATION CERTIFICATE
Filing Requirement of Act 74, Mich. P.A. 1970

For corners in

<u>Barry</u> (County)	Located in:	Corner Code #
1. Public Land Survey	T <u>4N</u> R <u>9W</u>	<u>G-2 (E 1/4 corner Sec. 4)</u>
	T ___ R ___	<u>Irving Twp.</u>
	T ___ R ___	_____
2. Property Controlling in Section	S ___ T ___ R ___	_____
3. Miscellaneous Property in Sec.	S ___ T ___ R ___	_____



2715
Page: 1 of 2
12/15/1998 08:24A

Sandy Schondelmayer - Barry Co. LCRCR

Register of Deeds Stamp & File Number

4. Lot No. _____, Recorded Plat _____
5. Private Claims _____

Steven Koerber, May 29 98

in a field survey on _____, 19____ do hereby state that under requirements of P.A. 74, Michigan P.A. of 1970, the corner points mentioned in lines 1 and 2 above were in conformance with regulations and rules therefore as required in the current manual of survey instructions of the United States Department of the Interior, Bureau of Land Management or by a decree of a Court of Law and/or that the corner points mentioned in lines 3, 4 and 5 above were in conformance with the rules of the Michigan Board of Land Surveyors or by a Decree of a Court of Law; established, re-established, monumented, recovered, found as expressed below:

NOTE: Not more than 2 corners, all in the same town and range, may be recorded on this certificate.

	A	B	C	D	E	F	G	H	I	J	K	L	M
1													
2	6		5		4		3		2		1		
3													
4	7		8		9		10		11		12		
5													
6	18		17		16		15		14		13		
7													
8	19		20		21		22		23		24		
9													
10	30		29		28		27		26		25		
11													
12	31		32		33		34		35		36		
13													

A. Description of original monument and accessories and/or subsequent restoration:

- | | | | |
|-----|---|---|--|
| G-2 | GLO- Set Post- Sibley, 1830
A.B. Oak 18 N41°E 10
A.W. Oak 12 S74°W 40 | 1. B.C. Rd. Comm.
no date
Iron & Crockery
24" Elm S25°W 46.1'
30" Elm N20°W 22.1'
T. Pole North 39.5'
20" Elm N60°W 47.5' | 2. B.C. Rd. Comm
Witness to P.I. #11
Wood stake over stone
S1°E 53.30' spike 12" Maple
S69°W 62.90' spike 6" Maple
N22°W 24.60' spike 12" Elm |
|-----|---|---|--|

(Additional info. on back)


B. Description of corner evidence found and/or method applied in restoring or reestablishing corner:

- G-2 Found 1" iron rod with crockery (as noted in No.1 above)
C/L cut off T. pole North 39.9'

ACT 345 BARRY COUNTY REMONUMENTATION
APPROVED BY PEER REVIEW AT A MEETING HELD ON
JAN 12, 1998 BR
BRIAN REYNOLDS COUNTY SURVEYOR

C. Description of monument for corner and accessories established to perpetuate locating the position of the corner:

- G-2 Replaced 1" iron rod with Barry Co. Mon. (3/4" x 24" Iron Rod with cap)
Set nail & washer in W side cut off T. pole N15°E 39.95'
Set nail & washer in E. side P. pole S5°E 28.38'
Set nail & washer in E side 14" Hackberry S25°W 44.81'
Nail & tag in W side 8" Oak N10°W 29.18'
Centerline Road South 2'
Iron rered S35°E 3.73'

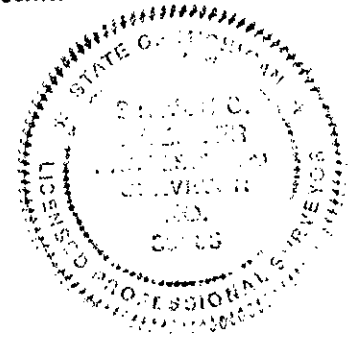

Signed by B. Reynolds
Surveyor's Michigan License No. 39085

Date 10-12-1998

FEB 03 1999

G-2 Irving Twp. Page 2 of 2

SECTION



2715

Page: 2 of 2
12/15/1998 08:24A

Sandy Sohndelmayer - Barry Co. LCRCR

3. L.C.R.C. #105 James King Nov-7-1973

Witnesses are gone

reset by proportional methods

Set 1/2" rerod

30" Oak North 67.2'

12" Oak N70°W 78.65'

NE corner Garage S30°W 79.20'

Fenceline North & South

4. Act 132 survey Liber 1, Pg. 145-150 James King Nov. 6, 1973
same wits as No. 3 above

5. Act 132 survey Liber 1, Pg 775 Paul Van Kooten March 13, 1984
same wits as No. 3 above
18" Oak W-NW 79.15'