

**SURVEY & REMONUMENTATION**

OCT 25 1993

**COMMISSION**

STATE OF MICHIGAN  
COUNTY OF BARRY  
RECEIVED FOR RECORD

AUG 18 8 00 AM '93

**LAND CORNER RECORDATION CERTIFICATE**  
Filing Requirement of Act 74, Mich. P.A. 1970

Sandy Schindelmaier  
REGISTER OF DEEDS

For corners in  
Barry

(County)

Located in:

Corner Code #

- |                                       |                         |                   |
|---------------------------------------|-------------------------|-------------------|
| 1. Public Land Survey                 | T <u>4N</u> R <u>9W</u> | <u>G9</u>         |
|                                       | T _____ R _____         | <u>IRVING TWP</u> |
|                                       | T _____ R _____         | _____             |
|                                       | T _____ R _____         | _____             |
| 2. Property Controlling in Section    | S _____ T _____ R _____ | _____             |
|                                       | S _____ T _____ R _____ | _____             |
| 3. Miscellaneous Property in Sec.     | S _____ T _____ R _____ | _____             |
|                                       | S _____ T _____ R _____ | _____             |
| 4. Lot No. _____, Recorded Plat _____ |                         |                   |
| 5. Private Claims _____               |                         |                   |

**002079**

Register of Deeds Stamp & File Number

	A	B	C	D	E	F	G	H	I	J	K	L	M
2	6	5	4	3	2								
3													
4	7	8	9	10	11	12							
5													
6	18	17	16	15	14	13							
7													
8	19	20	21	22	23	24							
9													
10	30	29	28	27	26	25							
11													
12	31	32	33	34	35	36							
13													

I, Gary C. Bilow, in a field survey on January 29, 1993, 19\_\_\_\_, do hereby certify that under requirements of P.A. 74, Michigan P.A. of 1970, the corner points mentioned in lines 1 and 2 above were in conformance with regulations and rules therefore as required in the current manual of survey instructions of the United States Department of the Interior, Bureau of Land Management or by a decree of a Court of Law and/or that the corner points mentioned in lines 3, 4 and 5 above were in conformance with the rules of the Michigan Board of Land Surveyors or by a Decree of a Court of Law; established, re-established, monumented, re-monumented, recovered, found as expressed below:

**NOTE: Not more than 4 corners, all in the same town and range, may be recorded on this certificate.**

**A. Description of original monument and accessories and/or subsequent restoration:**


G9: Post established by U. S. Deputy Surveyor S. Sibley in 1830 - accessories: Elm 6 S31-1/2W 20 links and White Oak 16 N57E 66 links. County Surveyor Frank Bowen records in 1874 for a survey of the South 1/2 of Section 22 "Commencing at the 1/4 post on west side Section 22 thence South on random 39.96 to Section corner 26 west of post." Bowen then records in Volume 1 page 271 for a survey in Section 21 "East on random from South 1/4 post 39.76 to Section corner 5 north of post - Stone by former survey - accessory: White oak 20 S45W 79." Barry County Road Commission records dated Oct. 1971 list three (3) witnesses: 6" Walnut N80W 30.7', 6" Oak S20E 51', and 12" Walnut S20W 56' but not what is there. Records obtained from P. Van Kooten (PS #08618) dated Aug. 1981 state "Found nothing - a local resident said the corner was a pointed stone sticking up in the center of the road but the Road Commission was tired of hitting it so they pulled it. Resident also said the stone was in direct line with the fence to the east and that he had seen Surveyors in years past use it. Set capped iron in center of road on fence to east - accessories: SE 31.68' spike in 20" Oak, SSE 43.22' spike in 20" Oak, NNE 65.60' spike in 36" Oak, and West 42.38' spike in 12" Walnut."

**B. Description of corner evidence found and/or method applied in restoring or reestablishing corner:**

G9: Found 1/2" iron bar 0.5' below road surface and one (1) of Van Kooten's witnesses. Accepted iron bar as the best evidence of the original G10 post.

**C. Description of monument for corner and accessories established to perpetuate locating the position of the corner:**

G9: Left 1/2" iron bar in place - Added plastic cap stamped "G.C. Bilow LLS 26453"  
N22E 65.21', Nail & Tag in 29" Oak  
N20W 46.35', Nail & Tag in 17" Oak  
N51E 33.65', Nail & Tag in 7" Oak  
Centerline North-South dirt road

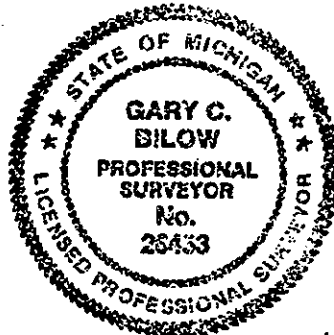

Signed by Gary C. Bilow Date 5/6/93  
Surveyor's Michigan License No. 26453

10/26/93