

STATE OF MICHIGAN  
COUNTY OF BARRY  
RECEIVED FOR RECORD

DEC 9 3 02 PM '93

Sandy Schondelmayer

REGISTER OF DEEDS

002144

002144

Register of Deeds Stamp & File Number

Barry County Remonumentation  
LAND CORNER RECORDATION CERTIFICATE  
Filing Requirement of Act 74, Mich. P.A. 1970

Barry County  
(County)

Located In: Irving Twp. Corner Code =#

Public Land Survey	T	4N	R	9W	H-3
	T		R		
	T		R		
	T		R		
Property Controlling in Section	S		T	R	
	S		T	R	
Miscellaneous Property in Sec.	S		T	R	
	S		T	R	

Lot No. \_\_\_\_\_, Recorded Plat \_\_\_\_\_  
Private Claims \_\_\_\_\_

	A	B	C	D	E	F	G	H	I	J	K	L	M
2	6		5		4		3		2		1		
3													
4	7		8		9		10		11		12		
5													
6	18		17		16		15		14		13		
7													
8	19		20		21		22		23		24		
9													
10	30		29		28		27		26		25		
11													
12	31		32		33		34		35		36		
13													

Robert Jonker in a field survey on February 18, 1993  
hereby certify that under requirements of P.A. 74, Michigan P.A. of 1970, the corner points mentioned lines 1 and 2 above were in conformance with regulations and rules therefore as required in the current manual of survey instructions of the United States Department of the Interior, Bureau of Land Management or by a decree of a Court of Law and/or that the corner points mentioned in lines 3, 4 and 5 above were in conformance with the rules of the Michigan Board of Land Surveyors or by a Decree of a Court of Law; established, re-established, monumented, re-monumented, recovered, found as expressed below:

NOTE: Not more than 4 corners, all in the same town and range, may be recorded on this certificate.

Description of original monument and accessories and/or subsequent restoration:

H-3, LCRC #104, Part A, lists "no witnesses", Jerry King, 1973  
LCRC #104, Part B, reset by proportional methods  
1/2" iron on fence line east, on C/L of N-S pavement  
12" Hickory N60°W 48.0'  
16" Hickory S20°W 73.55'  
T.pole S80°E 26.38'

Description of corner evidence found and/or method applied in restoring or reestablishing corner:

Found 1/2" solid pin by witnesses listed in "A" above.  
Accepted as the best evidence of the corner location.


SURVEY &  
REMONUMENTATION

APR 05 1994

COMMISSION

Description of monument for corner and accessories established to perpetuate locating the position of the corner:

Replaced with 3/4" x24" capped std. Barry County Monument.  
P.K. nail on sly. side p.pole S60°E 31.45'  
P.K. nail on Ely side nail box post N10°W 75.18'  
Nail on Ely. side 24" Hickory S30°W 73.89'  
Nail in Nly. side 8" Triple Ash S80°W 48.74'  
On C/L to N,S,W

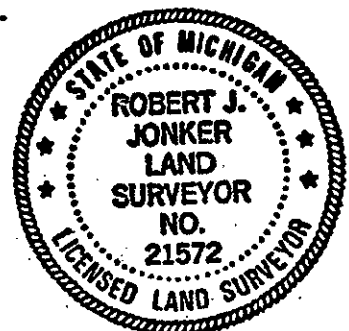

Robert J. Jonker  
Signed by Robert J. Jonker 21572  
Surveyor's Michigan License No.

Date 11/29/93