

BARRY COUNTY REMONUMENTATION
LAND CORNER RECORDATION CERTIFICATE
 Filing Requirement of Act 74, Mich. P.A. 1970

STATE OF MICHIGAN
 COUNTY OF BARRY
 RECEIVED FOR RECORD

DEC 14 8 54 AM '93

For corners in **BARRY**
 (County)

Located In: _____ Corner Code # _____

Sandy Schindelmarper
 REGISTER OF DEEDS

002178

Register of Deeds Stamp & File Number

1. Public Land Survey T 4N R 9W H-7
 T IRVING TWNSP.
 T 1/4 COR. SEC. 15,22
 T _____ R _____
 2. Property Controlling S _____ T _____ R _____
 in Section S _____ T _____ R _____
 3. Miscellaneous S _____ T _____ R _____
 Property In Sec. S _____ T _____ R _____
4. Lot No. _____, Recorded Plat _____
 5. Private Claims _____

BRIAN REYNOLDS

OCT

93

I, _____, in a field survey on _____, 19____, do hereby certify that under requirements of P.A. 74, Michigan P.A. of 1970, the corner points mentioned in lines 1 and 2 above were in conformance with regulations and rules therefore as required in the current manual of survey instructions of the United States Department of the Interior, Bureau of Land Management or by a decree of a Court of Law and/or that the corner points mentioned in lines 3, 4 and 5 above were in conformance with the rules of the Michigan Board of Land Surveyors or by a Decree of a Court of Law; established, re-established, monumented, re-monumented, recovered, found as expressed below:

	A	B	C	D	E	F	G	H	I	J	K	L	M
2	6	5	4	3	2	1							
3													
4	7	8	9	10	11	12							
5													
6	16	17	16	15	14	13							
7													
8	19	20	21	22	23	24							
9													
10	30	29	28	27	26	25							
11													
12	31	32	33	34	35	36							
13													

NOTE: Not more than 4 corners, all in the same town and range, may be recorded on this certificate.

A. Description of original monument and accessories and/or subsequent restoration:

- G.L.O.: WEST CORRECTED 39.95ch.; CHERRY - 10 - N37W - 40; W. OAK - 7 - S37E - 43.
- A.D. RORK: (COUNTY SURVEYOR RECORDS, Vol 2, Pg. 107) (20JUN1866) COMMENCING AT NE COR., BEARINGS FOUND, WEST ON RANDOM, 79.44ch. TO NW SEC. COR., BEARINGS FOUND, EAST CORRECTED, 39.72ch. SET STONE AND BRICK FOR CORNER: W. OAK - 10 - S49 1/2E - 77, Do. - N65 1/2E - 90
- LEE COBB: (BOOK IX, Pg. 113) (25-28NOV1890) IDENTIFIED COR. BY STONE AND BRICK AND STUMPS OF BEARINGS BY A.D. RORK; MADE NEW BEARINGS: SUG - 8 - N42W - 53, B. WALNUT - 5 - S44 1/4W - 53
- JAMES A. REDA: (LCRC #341) (13JAN1981) SET RR SPK. ON TREE LINE WEST & C/L BLKTP. AS PER Mr. ARTHUR KIDDER, AGE 87, OPPOSITE 44" MAPLE. (SEE BACK FOR WITNESSES)

B. Description of corner evidence found and/or method applied in restoring or reestablishing corner:

- SEE "DESCRIPTION OF CORNER EVIDENCE" ON BACK OF THIS FORM:


SURVEY &
 REMONUMENTATION

APR 05 1994

COMMISSION

C. Description of monument for corner and accessories established to perpetuate locating the position of the corner:

- SET BARRY Co. REMON. MONUMENT (IN MON. BOX)
- N&T - NE FACE - 28" MAPLE - N40W - 34.00'
- N&T - SE FACE - 28" BLACK WALNUT - N23E - 94.08'
- N&T - N. FACE - NW TRUNK - MAPLE CLUSTER - S69E - 52.10'
- N&T - W. FACE - 16" BLACK WALNUT - S23E - 74.27'
- N&T - NE SIDE - UTIL. POL - N11W - 114.67'
- RR SPIKE ON C/L - (FALSE S1/4 POST SET BY "JAMES REDA") - N11E - 23.45'
- C/L WOODSCHOOL Rd. - +/-4' - WEST.

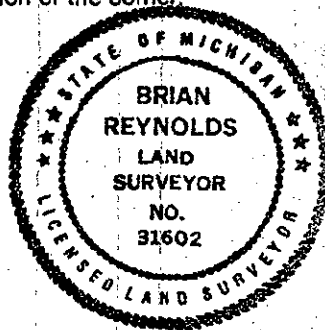

Signed by [Signature]
 Surveyor's Michigan License No. 31602

Date NOV 4TH, 1993

PART 'A' (CONTINUED)

- WITNESSES FOR H-7, T4N, R9W FROM L.C.R.C. #341:
(THIS HAS BEEN ESTABLISHED AS A FALSE CORNER)

RR SPK.:

CAP & NAIL IN SE SIDE 30" MAPLE N30E 70.79'

CAP & NAIL IN S SIDE 44" MAPLE WEST 27.57'

CAP & NAIL IN NE SIDE TRIPLE 12" MAPLE S35E 65.95'

SE COR HSE. FOUNDATION N55W 109.74'

ON C/L BLKTP. N. & S.

PART 'B' (CONTINUED)

- DESCRIPTION OF CORNER EVIDENCE FOUND:

D.N.R. SURVEYORS UNDER THE DIRECTION OF GARY BILOW, PS #26453, IN THE COURSE OF CONDUCTING A SURVEY OF STATE-OWNED LAND IN SECTION 21, MEASURED TO CORNERS AND OCCUPATION LINES IN THE NORTHWEST 1/4 OF SECTION 22. IN REFERENCE TO THE 1866 SURVEY BY RORK, AND THEIR CURRENT OCCUPATION MEASUREMENTS THEY CONCLUDED THAT THE RAILROAD SPIKE SET BY REDA WAS 26+/- FEET NORTH AND 4+/- FEET EAST OF THE TRUE CORNER. BILOW ALSO CONCLUDED THAT THE 44" MAPLE NOTED ON L.C.R.C. #341 WAS PROBABLY THE 8" SUG. NOTED BY COBB IN 1890. D.N.R. CHOSE NOT TO EXCAVATE; INSTEAD THEY TRANSMITTED THEIR INFORMATION TO BRIAN REYNOLDS, BARRY COUNTY SURVEYOR.

REYNOLDS SUBSEQUENTLY MEASURED THE NORTH AND SOUTH 1/4 LINE OF SECTION 15, LOCATING LINES OF OCCUPATION. THE RESULTS OF THESE MEASUREMENTS TENDED TO CONFIRM THE D.N.R. FINDINGS. ON OCTOBER 8, 1993, WITH ROAD COMMISSION ASSISTANCE, REYNOLDS EXCAVATED THROUGH THE BITUMINOUS ROAD SURFACE AT THE LOCATION INDICATED BY THE PROBABLE REMAINING WITNESS TREE. AT 4+/- FEET BELOW GRADE, FOUND A LARGE BLUE STONE WITH NUMEROUS PIECES OF BRICK. ACCEPTED THIS AS THE CORNER LOCATION RESET BY RORK AND PERPETUATED BY COBB. REMOVED STONE AND REPLACED WITH STANDARD BARRY COUNTY 3/4" x 24" IRON BAR AND ALUMINUM CAP, 4 FEET BELOW GRADE. TIED OFF IRON WITH P.K. NAILS IN BITUMINOUS PAVEMENT, FILLED IN EXCAVATION, AND SET ANOTHER STANDARD MONUMENT 6" BELOW GRADE. ON OCTOBER 15, 1993 ROAD SURFACE WAS REPAIRED AND MONUMENT BOX INSTALLED, REYNOLDS SUPERVISING.

SURVEY &
REMONUMENTATION

APR 05 1994

COMMISSION