

SURVEY & REMONUMENTATION

Barry County Remonumentation

MAR 09 1999

LAND CORNER RECORDATION CERTIFICATE
Filing Requirement of Act 74, Mich. P.A. 1970

SURVEY & REMONUMENTATION

MAR 09 1999

SECTION

SECTION

For corners in

Barry

Located In:

Corner Code #

(County)

1. Public Land Survey

T4N R9W

H-9 (South 1/4 cor Sec.22)

T R

Irving Twp.

T R

T R

2. Property Controlling in Section

S T R

S T R

3. Miscellaneous Property in Sec.

S T R

S T R



2711

Page: 1 of 1

12/15/1998 08:24A

Sandy Schondelmayer - Barry Co. LCRCR

Register of Deeds Stamp & File Number

4. Lot No. _____, Recorded Plat _____

5. Private Claims _____

I, Steven Koerber, in a field survey on Jan 5, 1998 do hereby state that under requirements of P.A. 74, Michigan P.A. of 1970, the corner points mentioned in lines 1 and 2 above were in conformance with regulations and rules therefore as required in the current manual of survey instructions of the United States Department of the Interior, Bureau of Land Management or by a decree of a Court of Law and /or that the corner points mentioned in lines 3, 4 and 5 above were in conformance with the rules of the Michigan Board of Land Surveyors or by a Decree of a Court of Law; established, re-established, monumented, recovered, found as expressed below:

NOTE: Not more than 2 corners, all in the same town and range, may be recorded on this certificate.

	A	B	C	D	E	F	G	H	I	J	K	L	M
1													
2	6		5		4		3		2		1		
3													
4	7		8		9		10		11		12		
5													
6	18		17		16		15		14		13		
7													
8	19		20		21		22		23		24		
9													
10	30		29		28		27		26		25		
11													
12	31		32		33		34		35		36		
13													

A. Description of original monument and accessories and/or subsequent restoration:

H-9 GLO- S. Sibley 1830
A.W. Oak 6 N18°W 16
Do. 9 S55°W 18

1. Bowen Nov. 4-6, 1874
Stone 18x6x8
W. Oak 12 N58 1/2°E 28 1/2


B. Description of corner evidence found and/or method applied in restoring or reestablishing corner:

H-9 Found capped rored
Fnd spike in S. side 36" Walnut West 30.41'
On C/L Wood School Road

ACT 345 BARRY COUNTY REMONUMENTATION
APPROVED BY PEER REVIEW AT A MEETING HELD ON
JAN 12, 1998 BR
BRIAN REYNOLDS COUNTY SURVEYOR

C. Description of monument for corner and accessories established to perpetuate locating the position of the corner:

H-9 Replaced capped rored with Barry Co. Mon. (3/4" x 24" Iron Rod with cap)
Fnd spike in S. side 36" Walnut West 30.41'
Set nail & washer in E. side 12" Hickory N40°W 58.06
Set nail & washer in S. side 10" Ash S75°W 62.23'
Set nail & washer in S. side 10" Walnut S70°E 42.86'
On C/L Wood School Road

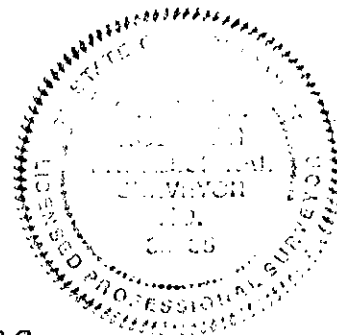

Signed by B. C. Kel
Surveyor's Michigan License No. 39085

Date 12-10-1998