STATE OF MICHIGAN
COUNTY OF BARRY
RECEIVED FOR RECORD

DEC 9 3 02 PM '93

Sandy Schondelmayer

REGISTER OF DEEDS

002148

Register of Deeds Stamp & File Number

Barry County Remonumentation

LAND CORNER RECORDATION CERTIFICATE

Filing Requirement of Act 74, Mich. P.A. 1970

For corners in

~~Barry County~~ (County)

Located in: Irving Twp.

Corner Code #

Public Land Survey	T 4N R 9W	I-4
	T ___ R ___	
	T ___ R ___	
	T ___ R ___	
Property Controlling	S ___ T ___ R ___	
in Section	S ___ T ___ R ___	
Miscellaneous	S ___ T ___ R ___	
Property in Sec.	S ___ T ___ R ___	

Lot No. _____, Recorded Plat _____

Private Claims _____

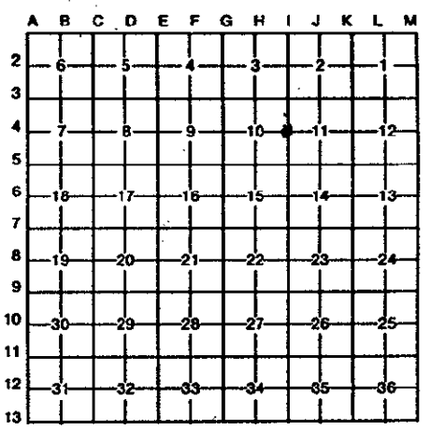

Robert Jonker, in a field survey on February 18, 19 93.

I do hereby certify that under requirements of P.A. 74, Michigan P.A. of 1970, the corner points mentioned in lines 1 and 2 above were in conformance with regulations and rules therefore as required in the current manual of survey instructions of the United States Department of the Interior, Bureau of Land Management or by a decree of a Court of Law and/or that the corner points mentioned in lines 3, 4 and 5 above were in conformance with the rules of the Michigan Board of Land Surveyors or by a Decree of a Court of Law; established, re-established, monumented, re-monumented, recovered, found as expressed below:

NOTE: Not more than 4 corners, all in the same town and range, may be recorded on this certificate.

Description of original monument and accessories and/or subsequent restoration:

No info available for County Surveyors Office
No info available for County Road Commission
Set corner at the intersection of N-S fences @ fences to West & measured to section corner to N & S and center to West, to verify position, per LCRC #472, Jonker, 1993.
Spike N.side 30"Oak N85°W 13.65'
Spike S.side 18" Oak N45°E 19.50'
Spike W.side 12"W.Ch. S10°E 30.3'
Spike N.side 14" W.Ch. S40°E 29.22'

Description of corner evidence found and/or method applied in restoring or reestablishing corner:

Found capped iron per witnesses listed in "A" above.

And is accepted as the best available evidence of the position of the original corner.

SURVEY & REMONUMENTATION

APR 0 5 1994

COMMISSION

Description of monument for corner and accessories established to perpetuate locating the position of the corner:

Replaced with 3/4"x36" std., capped Barry County Monument.

Spike N.side 30" Oak N85°W 13.65'
Spike S.side 18" Oak N45°E 19.50'
Spike W.side 12" Cherry S10°E 30.30'
Spike N.side 14" Cherry S40°E 29.22'

STATE OF MICHIGAN
ROBERT J. JONKER
LAND SURVEYOR
NO. 21572
LICENSED LAND SURVEYOR

Signed by Robert J. Jonker Date 11/29/93

Jonker, Robert J.

Surveyor's Michigan License No. #21572

FORM APPROVED BY MICHIGAN STATE BOARD OF LAND SURVEYORS, JAN. 28, 1971
REVISED MAY 14, 1975
REVISED JAN., 1983