

**SURVEY &
REMONUMENTATION**

FEB 03 1999

SECTION

Barry County Remonumentation

LAND CORNER RECORDATION CERTIFICATE
Filing Requirement of Act 74, Mich. P.A. 1970

For corners in

<u>Barry</u> (County)	Located In:	Corner Code #
1. Public Land Survey	T <u>4</u> N R <u>9</u> W	I-8 (East 1/4 cor Sec.22)
	T ___ R ___	Irving Twp.
	T ___ R ___	___
	T ___ R ___	___
2. Property Controlling in Section	S ___ T ___ R ___	___
	S ___ T ___ R ___	___
3. Miscellaneous Property in Sec.	S ___ T ___ R ___	___
	S ___ T ___ R ___	___



2710
Page: 1 of 1
12/15/1998 08:24A

Sandy Schondelmayer - Barry Co. LCRCR

Register of Deeds Stamp & File Number

4. Lot No. _____, Recorded Plat _____
5. Private Claims _____

I, Steven Koerber, in a field survey on Jan 5, 1998, do hereby state that under requirements of P.A. 74, Michigan P.A. of 1970, the corner points mentioned in lines 1 and 2 above were in conformance with regulations and rules therefore as required in the current manual of survey instructions of the United States Department of the Interior, Bureau of Land Management or by a decree of a Court of Law and/or that the corner points mentioned in lines 3, 4 and 5 above were in conformance with the rules of the Michigan Board of Land Surveyors or by a Decree of a Court of Law; established, re-established, monumented, recovered, found as expressed below:

NOTE: Not more than 2 corners, all in the same town and range, may be recorded on this certificate.

	A	B	C	D	E	F	G	H	I	J	K	L	M
1													
2		6		5		4		3		2		1	
3													
4		7		8		9		10		11		12	
5													
6		18		17		16		15		14		13	
7													
8		19		20		21		22	●	23		24	
9													
10		30		29		28		27		26		25	
11													
12		31		32		33		34		35		36	
13													

A. Description of original monument and accessories and/or subsequent restoration:

- | | | | |
|-----|--|---|--|
| I-8 | GLO- S. Sibley 1830
A.W. Oak 12 S32°W 30
Do. 15 N34°E 29 | 1. AD Rork Aug. 17, 1866
Took new bearing
W. Oak 12 N13 1/2°W 155 | 2. L.C.R.C. No. 311
Feb. 12, 1981 William Byl
1/2" steel bar 10" deep
10" Ash NNW 38.12'
36" Maple ESE 40.93'
Power Pole SSE 55.54' |
| | 3. Barry Co. Rd. Comm. 1982
Road plans
Same witnesses as No. 2 above | | |


B. Description of corner evidence found and/or method applied in restoring or reestablishing corner:

- I-8 Found rerod
Fnd PK nail in Power Pole SSE 55.54'

ACT 345 BARRY COUNTY REMONUMENTATION
APPROVED BY PEER REVIEW AT A MEETING HELD ON
JAN 12, 1998 BR
BRIAN REYNOLDS COUNTY SURVEYOR

C. Description of monument for corner and accessories established to perpetuate locating the position of the corner:

- I-8 Replaced rerod with Barry Co. Mon. (3/4" x 24" Iron Rod with cap)
Fnd spike in N. side 12" Poplar N55°W 50.93'
Set nail & washer in E. side P. Pole S20°E 56.00'
Set nail & washer in N. side 40" Maple S45°E 42.63'
Set nail & washer in E. side 20" Hickory N5°W 38.91'

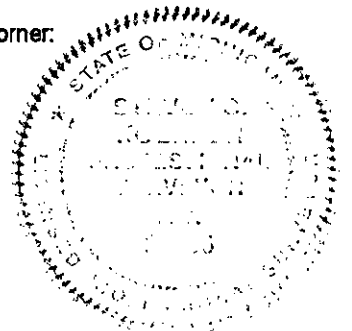

Signed by B. C. K.
Surveyor's Michigan License No. 39085

Date 12-10-1998