

FEB 03 1999

SECTION

Barry County Remonumentation

LAND CORNER RECORDATION CERTIFICATE
Filing Requirement of Act 74, Mich. P.A. 1970

For corners in

Barry

(County)

Located In:

Corner Code #

1. Public Land Survey

T 4N R 9W

I-9 (SE cor Sec.22)

T R

Irving Twp.

T R

T R

2. Property Controlling in Section

S T R

S T R

3. Miscellaneous Property in Sec.

S T R

S T R



2709

Page: 1 of 1
12/15/1998 08:24A

Sandy Schondelmayer - Barry Co. LCRCR

Register of Deeds Stamp & File Number

4. Lot No. _____, Recorded Plat _____
5. Private Claims _____

I, Steven Koerher, in a field survey on Jan 5, 19 98 do hereby state that under requirements of P.A. 74, Michigan P.A. of 1970, the corner points mentioned in lines 1 and 2 above were in conformance with regulations and rules therefore as required in the current manual of survey instructions of the United States Department of the Interior, Bureau of Land Management or by a decree of a Court of Law and /or that the corner points mentioned in lines 3, 4 and 5 above were in conformance with the rules of the Michigan Board of Land Surveyors or by a Decree of a Court of Law; established, re-established, monumented, recovered, found as expressed below:

NOTE: Not more than 2 corners, all in the same town and range, may be recorded on this certificate.

	A	B	C	D	E	F	G	H	I	J	K	L	M
1													
2	6	5	4	3	2	1							
3													
4	7	8	9	10	11	12							
5													
6	18	17	16	15	14	13							
7													
8	19	20	21	22	23	24							
9													
10	30	29	28	27	26	25							
11													
12	31	32	33	34	35	36							
13													

A. Description of original monument and accessories and/or subsequent restoration:

I-9 GLO- S. Sibley 1830
A.W. Oak 22 S64°E 32
Do. 6 N17 1/2°W 31

1. Irving Twp. field book
A.W. Oak 18 N62°W 57
Do. 16 N68°E 58

2. March 18-19, 1892
Identified by stone & Bearing set 1889
Lee Cobb
Book IX


B. Description of corner evidence found and/or method applied in restoring or reestablishing corner:

I-9 Found stone
Fnd nail in E. side 10" Hickory N10°W 14.11'
Fnd. nail in N. side 12" Hickory N85°W 26.82'
Fnd. nail in N. side 12" Maple S35°E 11.25'

ACT 345 BARRY COUNTY REMONUMENTATION
APPROVED BY PEER REVIEW AT A MEETING HELD ON
JAN 12, 1998 BR
BRIAN REYNOLDS COUNTY SURVEYOR

C. Description of monument for corner and accessories established to perpetuate locating the position of the corner:

I-9 Replaced stone with Barry Co. Mon. (3/4" x 24" Iron Rod with cap) surrounded by a ring of stones
Set nail & washer in S. side 12" Oak N45°E 30.49'
Fnd nail in E. side 10" Hickory N10°W 14.11'
Fnd. nail in N. side 12" Hickory N85°W 26.82'
Fnd. nail in N. side 12" Maple S35°E 11.25'

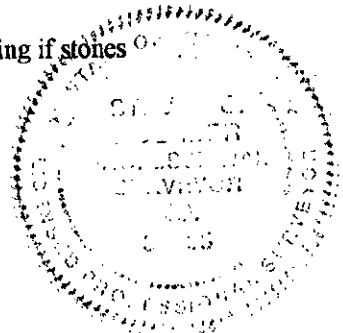

Signed by

[Signature]

Date 12-10-1998

Surveyor's License No. _____

29085