

SURVEY & REMONUMENTATION

AUG 31 1994

COMMISSION

For corners in

BARRY

(County)

BARRY COUNTY REMONUMENTATION

LAND CORNER RECORDATION CERTIFICATE

Filing Requirement of Act 74, Mich. P.A. 1970

STATE OF MICHIGAN
COUNTY OF BARRY
RECORDED FOR RECORD

JUL 8 12 42 PM '94

Sandy Schindelmayr

REGISTER OF DEEDS

002207

Register of Deeds Stamp & File Number

- 1. Public Land Survey T 4N R 9W I-10
T IRVING TWNSP.
T 1/4 COR. SEC 26 & 27
T _____ R _____
- 2. Property Controlling in Section S _____ T _____ R _____
- 3. Miscellaneous S _____ T _____ R _____
 Property in Sec. S _____ T _____ R _____
- 4. Lot No. _____, Recorded Plat _____
- 5. Private Claims _____

A	B	C	D	E	F	G	H	I	J	K	L	M
2	6	5	4	3	2	1						
3												
4	7	8	9	10	11	12						
5												
6	18	17	16	15	14	13						
7												
8	19	20	21	22	23	24						
9												
10	30	29	28	27	26	25						
11												
12	31	32	33	34	35	36						

I, **BRIAN REYNOLDS**, in a field survey on 26 APR, 1994, do hereby certify that under requirements of P.A. 74, Michigan P.A. of 1970, the corner points mentioned in lines 1 and 2 above were in conformance with regulations and rules therefore as required in the current manual of survey instructions of the United States Department of the Interior, Bureau of Land Management or by a decree of a Court of Law and/or that the corner points mentioned in lines 3, 4 and 5 above were in conformance with the rules of the Michigan Board of Land Surveyors or by a Decree of a Court of Law; established, re-established, monumented, re-monumented, recovered, found as expressed below:

NOTE: Not more than 4 corners, all in the same town and range, may be recorded on this certificate.

A. Description of original monument and accessories and/or subsequent restoration:

- G.L.O.: SYLVESTER SIBLEY D.S., 1830 (R9W, Pg. 164):
 W. OAK - 9 - N9W - 42; Do. - 6 - S25E - 58
- LEE COBB, 18 & 19 MAR 1892 (BOOK IX, Pg. 127): FOUND STONE & BRICK:
 CHERRY - 9 - S41 1/2W - 41 1/2 links; APPLE - 9 - N27W - 52 1/2 (or 62 1/2) NOT BLAZED.
- GREG JENSEN, 1992, SET 1/2" IRON FROM WORK IN SECTION 27 IRVING TWNSP.:
 PL. IR 2' N. TRAV. C/L DIRT RD.; C/L P.P. - N70E - 57.7'; SPLIT RAIL FC. - N. - 36.0'
 N. END - 12" CMP CULVERT - N80W - 63.0'

B. Description of corner evidence found and/or method applied in restoring or reestablishing corner:

- AFTER FINDING THE N1/8 COR. OF THE SW1/4 SEC. 26 IRVING AS CALLED FOR IN SURVEY BY LEE COBB (1892), COMPUTED POSITION FOR W1/4 CORNER SEC. 26 IRVING BY DOUBLING DISTANCE WEST FROM N. - S. 1/4 LINE TO FOUND 1/8 CORNER AND HOLDING LINE FROM EAST 1/4 CORNER THROUGH FOUND 1/8 CORNER. COMPUTED CORNER CAME OUT ROUGHLY 8' EAST OF JENSEN'S POSITION. EXCAVATED AND FOUND LARGE STONE & BRICK AS CALLED FOR BY COBB (1892).


ACCEPTED FOUND STONE AS COBB'S PERPETUATION OF CORNER POSITION.

ACT 345 BARRY COUNTY REMONUMENTATION APPROVED BY PEER REVIEW AT A MEETING HELD ON

MAY 3, 1994 BR
 BRIAN REYNOLDS COUNTY SURVEYOR

C. Description of monument for corner and accessories established to perpetuate locating the position of the corner:

- SET BARRY Co. REMONUMENTATION MONUMENT IN PLACE OF FOUND STONE AND BRICK:
- ON C/L E. - W. ROAD; +/- 9' EAST OF SPLIT RAIL FENCE NORTH.
- N&T - SE. SIDE - UTIL. POLE - N53E - 53.44'
- N&T - SW. FACE - 10" BLACK CHERRY - S36E - 66.82'
- N&T - E. FACE - 24" OAK - S4E - 81.05'
- N&T - E. FACE - 12" ELM - S24W - 95.23'
- N&T - SE. FACE - 15" BLACK CHERRY - S48W - 72.35'
- N&T - W. SIDE - 4" x 4" WOOD POST - N15W - 33.41'
- (9.03' - S78E - FROM JENSEN'S POSITION. JENSEN'S IRON WAS REMOVED)

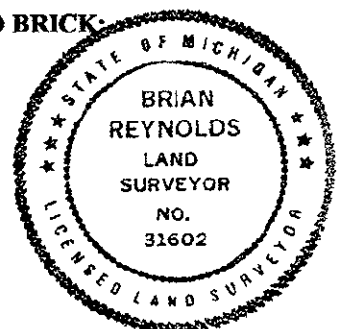

Signed by [Signature]
 Surveyor's Michigan License No. 31602

Date JUNE 20, 1994